IREDELL COUNTY HEALTH DEPARTMENT

Statesville Phone TR 3-7271 . Mooresville Phone No. 664-5281

PERMIT TO INSTALL SEPTIC TANK

Permit No. 167 Permit Date 7-9- 1973

Owner Avery & Tomel (builder) Address Mooresville

Installed By Honeycutt Orbison Address Mooresville


Location of Property 115 N TR on Road to Collins Park Lot 8

Tank		Capacity		Length of Lines		Fixtures	
Block	( )	1000	(✓)	225'	( )	No. of Baths	(1 1/2
Precast	(✓)	1250	( )	250'	( )	Dishwasher	(no
		1500	( )	Other 200'		Garbage Grdr.	(no
		Other				Other Washing Machine	

NOTIFY HEALTH DEPARTMENT AT LEAST EIGHT HOURS BEFORE TANK IS TO BE INSPECTED.

Final Inspection 7-9- 1973 Approved (✓) Disapproved ( )

Remarks Lot was so that it prevent going 75' long with ditch, was 9' wide to give give square footage.

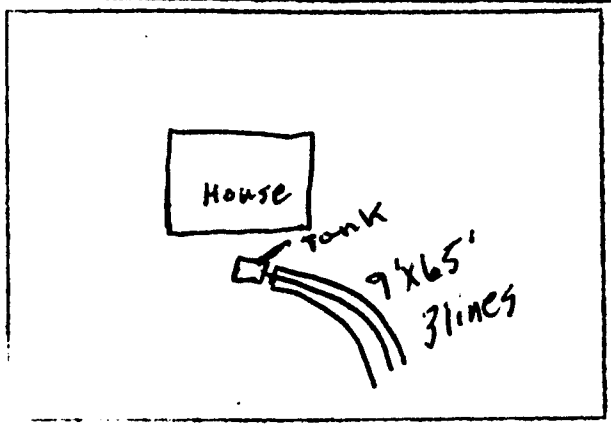

Sketch of Installation

J. C. Moore

Sanitarian