IREDELL COUNTY HEALTH DEPARTMENT

STATESVILLE 704-878-5305 MOORESVILLE 704-664-5281

IMPROVEMENT PERMIT / AUTHORIZATION TO CONSTRUCT / OPERATION PERMIT / EXISTING SYSTEM INSPECTION

PERMIT# 073368 PIN# 4658 84 9772 4658 95 00560 DATE June 3, '98

OWNER OR CONTRACTOR Krom Financial PHONE: Business 664-3671 Home

ADDRESS 149 Yacht Cove Rd. Mooresville

LOCATION 115 N. TR Barclay TR New Street 4th lot on left 153 Creek Branch

SUBDIVISION Collins Park BLOCK / SECTION II LOT 4 LOT AREA 1.34Ac SITE CLASS. PS DESIGN FLOW 360gpd L.T.A.R. .03

Septic Tank: 1000 Gallons; STB 325 Date 10/12/98
Pump Tank: 1000 Gallons; PT 47 Date 10/27/98
Pump Make: Model Serial No.
Nitrification Field: No Fields 1 Square Feet 900 Linear Feet 300
No Lines 4@75' Trench Width 36" Max Trench Bottom Depth 18-24" Gravel Depth NA

☑ New System ☐ Repair System Type: I, II, III, IV, V, VI
System Description: Pumped - pm- MOD 25% Red.
Repair System Description: LP to Modified 25%
Maintenance Agreement Required: ☐ Yes ☑ No initially

☑ House/Mod. Home No. Bedrooms 3
☐ Mobile Home No. Bathrooms 2
☐ Business No. Employees
☐ Other
☐ Slab ☑ Crawl Space ☐ Basement w/plumbing ☐ Basement wo/plumbing


Water Supply: ☑ Individual ☐ Public ☐ Community

Comments:/Conditions: * ONE Inspection/observation port per Lateral


Comments:/Conditions:

1" = 50'

INITIAL SITE SKETCH

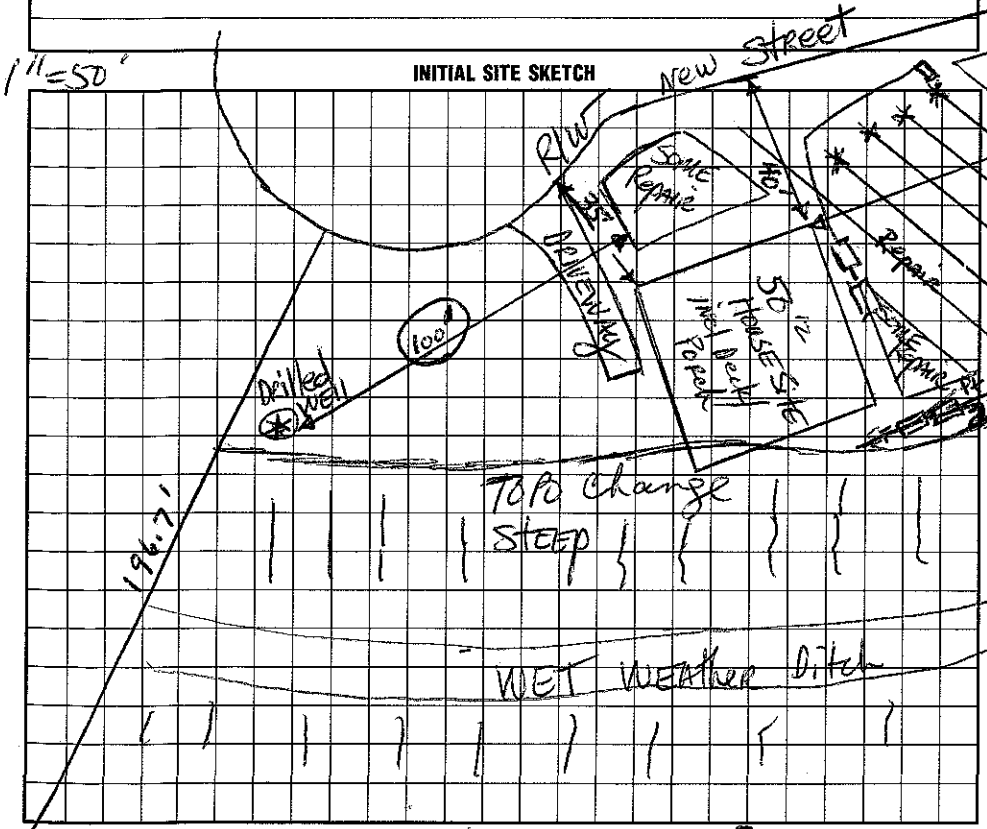

AS BUILT SKETCH

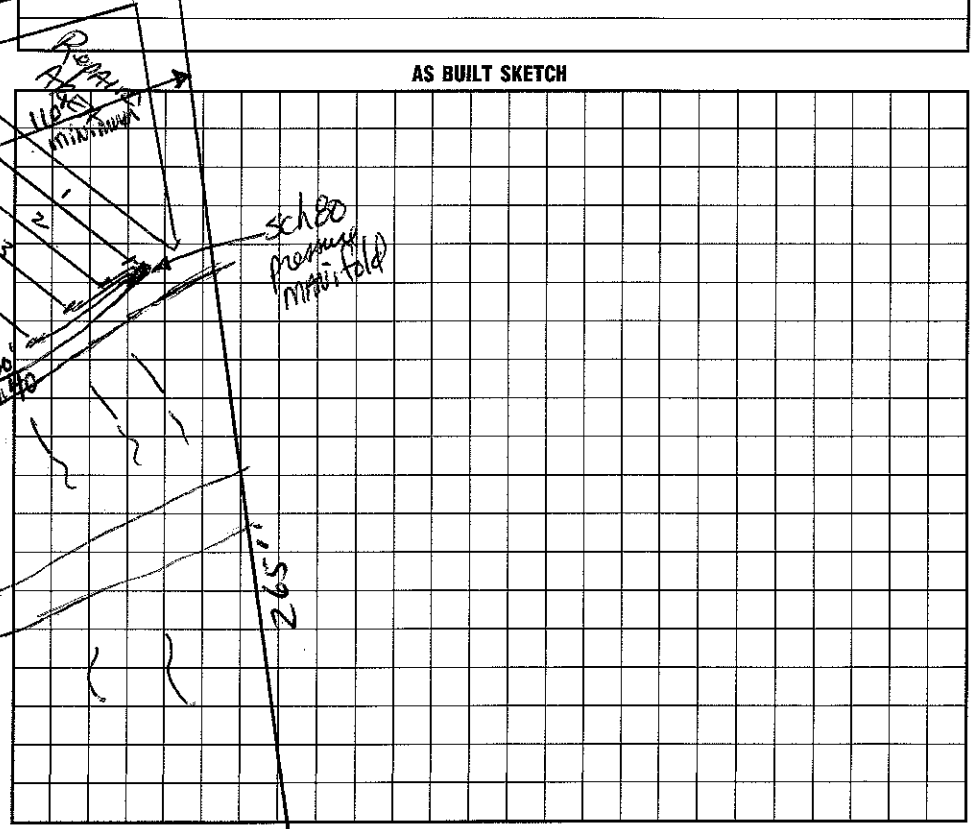

I understand that this permit can be suspended or revoked if any false information is supplied toward securing the permit/any unauthorized changes are made to the site/any unauthorized changes are made in the installation of the system. Improvement Permit with plat valid without expiration. Improvement Permit with site plan valid for sixty months. Authorization to Construct is valid for a period equal to that of Improvement Permit – not to exceed sixty months.

Signed: date 6-15-98 Installed by: Rowan Septic Tank

Improvement Permit by: IRS date 6-3-98 Operation Permit by: Wesley Sparks RS date 12/22/98

Authorization to Construct by: IRS date 6-18-98 Existing System Inspection by: date

HEALTH DEPT. COPY: WHITE INSPECTION COPY (FINAL): GREEN OWNER COPY (FINAL): YELLOW INSPECTION COPY (INITIAL): PINK OWNER COPY (INITIAL): GOLD