IREDELL COUNTY HEALTH DEPARTMENT

STATESVILLE 704-878-5305 — Delbert 932-7904, 213 — MOORESVILLE 704-664-5281

IMPROVEMENT PERMIT / AUTHORIZATION TO CONSTRUCT / OPERATION PERMIT / EXISTING SYSTEM INSPECTION

PERMIT# 28913 PIN# 4658896666 4658961664 DATE 7-12-05

OWNER OR CONTRACTOR Michael Leazer PHONE: Business Home 663-4656

ADDRESS 158 Little Creek Rd Mooresville NC 28115

LOCATION Hwy 115 TL Shinnville TR Little Creek stay right at fork, property on left

SUBDIVISION — BLOCK / SECTION — LOT — LOT AREA 2.581 Acre SITE CLASS. JPS DESIGN FLOW 240 gpd L.T.A.R. 3+

Septic Tank: 1000 Gallons; STB 825 Date 5/25

Pump Tank: — Gallons; PT — Date —

Pump Make: — Model — Serial No. —

Nitrification Field: No Fields 1 Square Feet 810' Linear Feet 270'

No Lines 3@90 Trench Width 36" Max Trench Bottom Depth 36" Gravel Depth 12"

[X] New System [ ] Repair System Type: I, II, III, IV, V, VI

System Description: Gravity-Conventional

Repair System Description: Same

Maintenance Agreement Required: [ ] Yes [X] No

[ ] House/Mod. Home [X] Mobile Home [ ] Business [ ] Other

No. Bedrooms 2 No. Bathrooms 2 No. Employees —

[ ] Slab [X] Crawl Space [ ] Basement w/plumbing [ ] Basement wo/plumbing


Water Supply: [X] Individual Shared [ ] Public [ ] Community

Comments:/Conditions: Keep Septic System at least 10' to PL, 10' to house & 100' to "shared well".


Comments:/Conditions:

INITIAL SITE SKETCH

*Not to Scale P=Porch

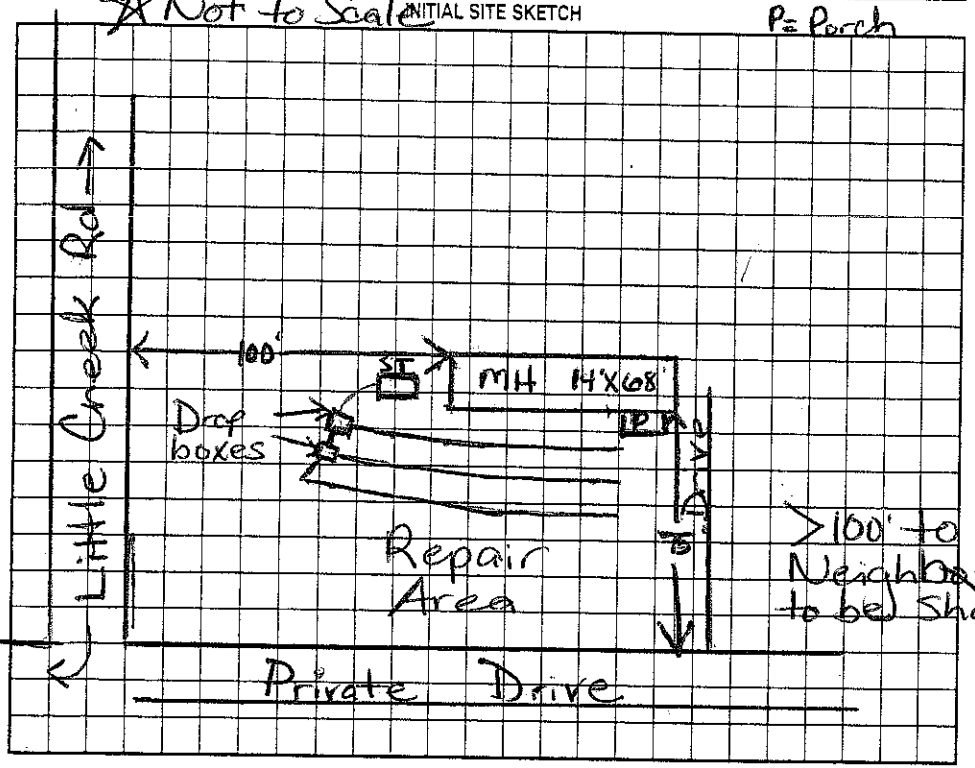

AS BUILT SKETCH

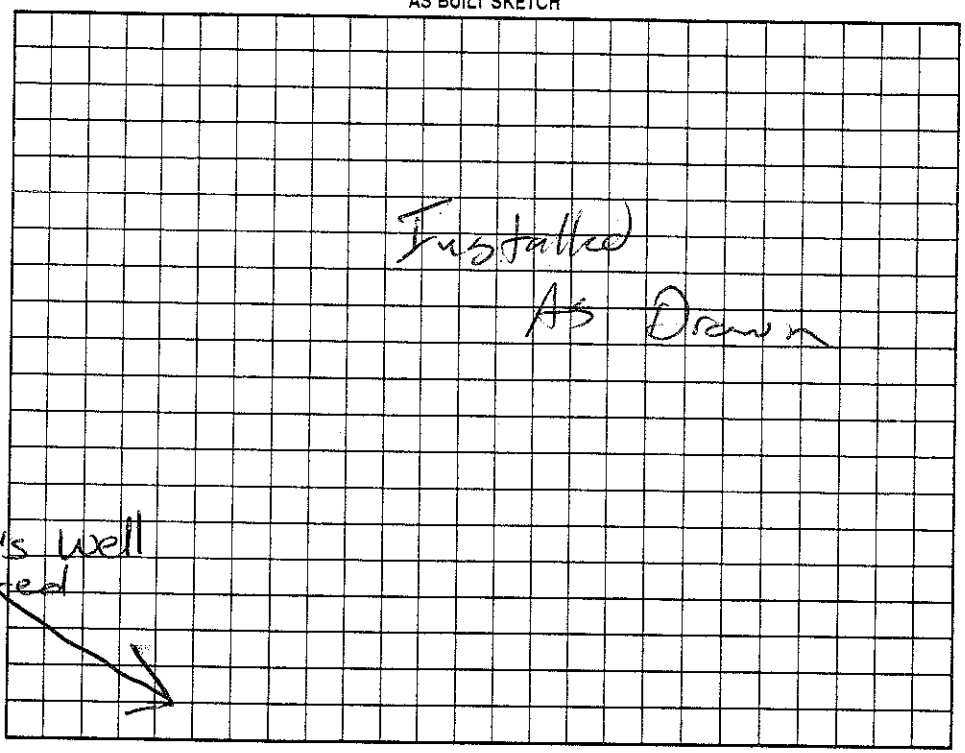

Permit can be suspended or revoked if any false information is supplied toward securing the permit/any unauthorized changes are made to the site/any unauthorized changes are made in the installation of the system. Improvement Permit with plat valid without expiration. Improvement Permit with site plan valid for sixty months. Authorization to Construct is valid for a period equal to that of Improvement Permit – not to exceed sixty months.

Signed: Jake Compton date 7-12-05 Installed by: Delbert Bostian

Improvement Permit by: Marian H. Dotson RS date 7/12/05 Operation Permit by: RS date 7/14/05

Authorization to Construct by: Marian H. Dotson RS date 7/12/05 Existing System Inspection by: date

HEALTH DEPT. COPY: WHITE OWNER COPY (FINAL): YELLOW OWNER COPY (INITIAL): PINK