4658968998

IREDELL COUNTY HEALTH DEPARTMENT

STATESVILLE 704-878-5305 MOORESVILLE 704-664-5281

IMPROVEMENT PERMIT / CERTIFICATE OF COMPLETION / OPERATION PERMIT / EXISTING SYSTEM INSPECTION

PROPERTY DESCRIPTION NO. 21791 DATE 7/31/95 TAX MAP NO. IM A 152 Watershed: ☐ Yes ☒ No

OWNER OR CONTRACTOR Angela S. Boyd PHONE: Business _____ Home 394-4463

ADDRESS 7641 Fieldridge Rd. Charlotte, NC. 28294

LOCATION Shinnville Rd TR on Little Creek TL to 3rd lot on L

SUBDIVISION _____ BLOCK / SECTION _____ LOT _____ LOT AREA _____ SITE CLASS. PS DESIGN FLOW 480 L.T.A.R. .3

Septic Tank: 1000 Gallons; STB 821 Date 9/18/95

Pump Tank: _____ Gallons; PT _____ Date _____

Pump Make: _____ Model _____ Serial No. ~~X 400~~ (533)

Nitrification Field: No. Fields 1 Square Feet 1600 Linear Feet (533)

No. Lines 4 Trench Width 36" Max Trench Bottom Depth 32" Gravel Depth N/A

☒ New System ☐ Repair System Type: I, II, ☒ III, IV, V, VI

System Description: DROP BOX - INFILTRATOR

Repair System Description: _____

Maintenance Agreement Required: ☐ Yes ☒ No

☐ House/Mod. Home No. Bedrooms 4

☒ Mobile Home No. Bathrooms 2

☐ Business No. Employees ____

☐ Other _____


☐ Slab ☒ Crawl Space ☐ Basement w/plumbing ☐ Basement wo/plumbing

Water Supply: ☒ Individual ☐ Community ☐ Public

Comments: ~~X~~ 25% reduction for INFILTRATOR USE

Comments:

INITIAL SITE SKETCH

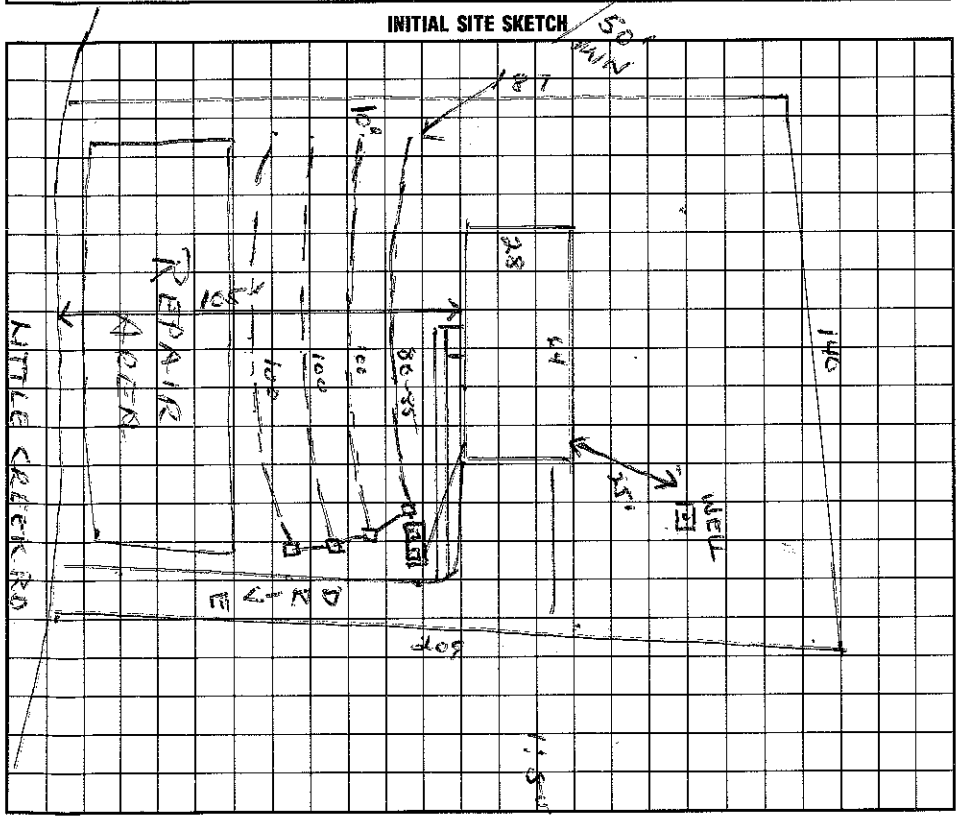

AS BUILT SKETCH

I understand that this permit can be suspended or revoked if any false information is supplied toward securing the permit/any unauthorized changes are made to the site/any unauthorized changes are made in the installation of the system. Improvement Permit is valid for 60 months from date of issuance.

Signed: [signature]

Improvement Permit by: Wesley Sparks R.S. date 7/31/95

Existing System Inspection by: _____ date _____

Installed by: J + M Enterprises

Certificate of Completion by: Wesley Sparks R.S. date 9/19/95

Operation Permit by: _____ date _____

HEALTH DEPT. COPY: WHITE INSPECTION COPY (FINAL): GREEN OWNER COPY (FINAL): YELLOW INSPECTION COPY (INITIAL): PINK OWNER COPY (INITIAL): GOLD