IMPROVEMENT PERMIT / AUTHORIZATION TO CONSTRUCT / OPERATION PERMIT / EXISTING SYSTEM INSPECTION

STATESVILLE 704-878-5305 — MOORESVILLE 704-664-5281

PERMIT# 130304 PIN# 4658969721

OWNER OR CONTRACTOR Paul Recore

ADDRESS 192 Little Creek Rd

LOCATION

Trench Width 36" Max Trench Bottom Depth 36" Maintenance Agreement Required: ☐ Yes ☒ No Gravel Depth NA ☐ Slab ☒ Crawl Space ☐ Basement w/plumbing ☐ Basement wo/plumbing

☐ Mobile Home ☐ Business ☐ Other No. Bathrooms ___ No. Employees ___

Water Supply: ☒ Individual ☐ Public ☐ Community


Comments:/Conditions:

Comments:/Conditions:


Red Poly-tek filter ST w/ risers

1" = 60'

INITIAL SITE SKETCH

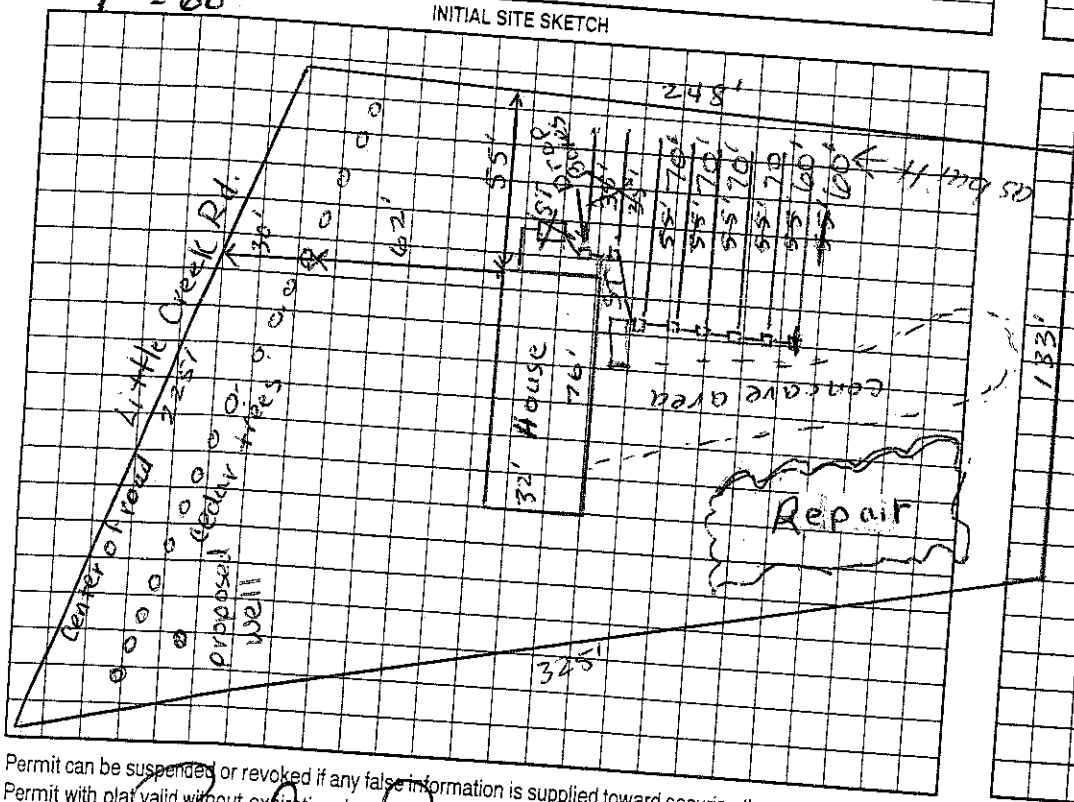

AS BUILT SKETCH

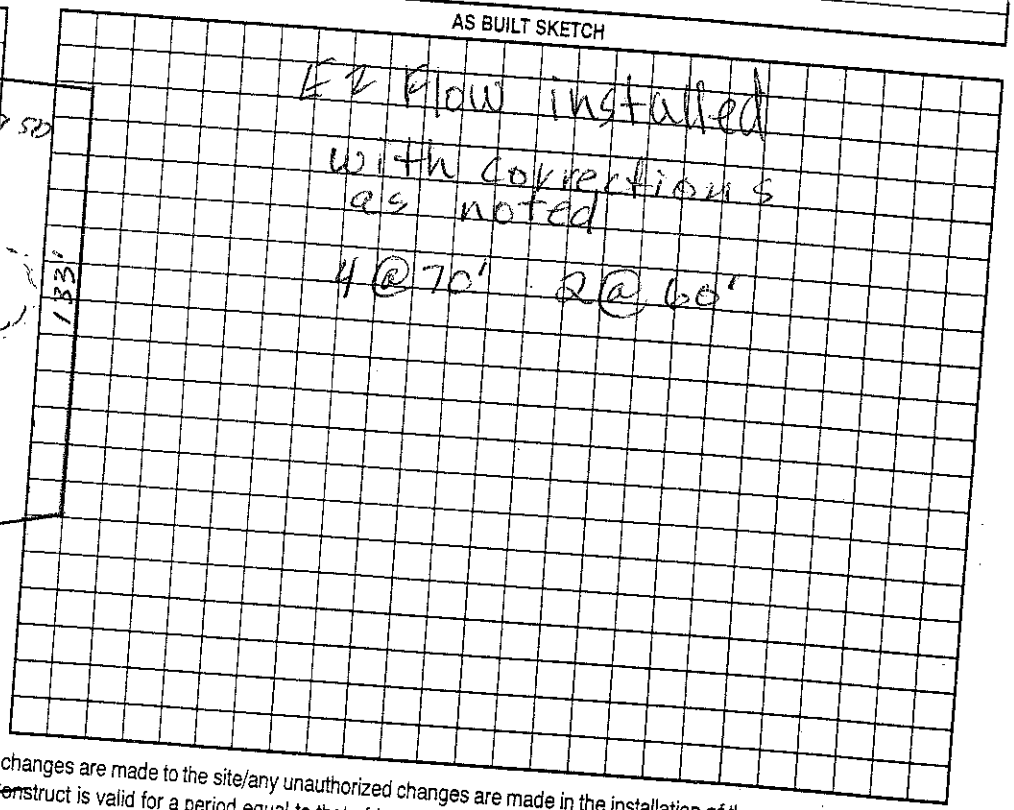

Permit can be suspended or revoked if any false information is supplied toward securing the permit/any unauthorized changes are made to the site/any unauthorized changes are made in the installation of the system. Improvement Permit with plat valid without expiration. Improvement Permit with site plan valid for sixty months. Authorization to Construct is valid for a period equal to that of Improvement Permit – not to exceed sixty months.

Signed: Paul W Recore date 8-9-05

Improvement Permit by: Judy Melville date 8-18-05

Authorization to Construct by: Judy Melville date 8-18-05

Installed by: Tim Ammons

Operation Permit by: Judy Melville date 4-5-07

Existing System Inspection by: ___ date ___

HEALTH DEPT. COPY: WHITE OWNER COPY (FINAL): YELLOW OWNER COPY (INITIAL): PINK