4658970374

IREDELL COUNTY HEALTH DEPARTMENT

STATESVILLE 704-878-5305 MOORESVILLE 704-664-5281

IMPROVEMENT PERMIT / CERTIFICATE OF COMPLETION / OPERATION PERMIT / EXISTING SYSTEM INSPECTION

PROPERTY DESCRIPTION NO. 18148 DATE 10/17/94 TAX MAP NO. 1Q A 52 Watershed: ☐ Yes ☑ No

OWNER OR CONTRACTOR Paul Combs PHONE: Business ______ Home 664-3290

ADDRESS Rt 4 Box 959 Mooresville, NC. 28115

LOCATION 21-115 N TR Shinnville TR first gravel to 2nd MH on (R)

SUBDIVISION Combs BLOCK / SECTION ______ LOT 1 LOT AREA ~.03 Ac SITE CLASS. P DESIGN FLOW 360 L.T.A.R. .3

Septic Tank: 1000 Gallons; STB 825 Date 5/20/95

Pump Tank: ______ Gallons; PT ______ Date ______

Pump Make: ______ Model 1200 ft² Serial No. 300 ft²

Nitrification Field: No Fields ______ Square Feet ~~1440~~ Linear Feet ~~460~~ X

No Lines 4 lines Trench Width 24" Max Trench Bottom Depth 30" Gravel Depth 12"

☑ New System ☐ Repair System Type: I, II, (III), IV, V, VI

System Description: DIST. BOX PPBS 16"

Repair System Description: ______

Maintenance Agreement Required: ☐ Yes ☐ No

☐ Slab ☑ Crawl Space ☐ Basement w/plumbing ☐ Basement wo/plumbing

☐ House/Mod. Home ☑ Mobile Home ☐ Business ☐ Other ______


No. Bedrooms 3 No. Bathrooms 1 No. Employees ______

Water Supply: ☑ Individual ☐ Community ☐ Public — From White

Comments: Survey run from gravel road R/W
* 16" PPBS DRAINFIELD Allows 50% reduction
MAXIMUM TRENCH DEPTH 30"

Comments:
* Changed to 300 feet of infiltrator with drop box distribution. 7/28/95

INITIAL SITE SKETCH

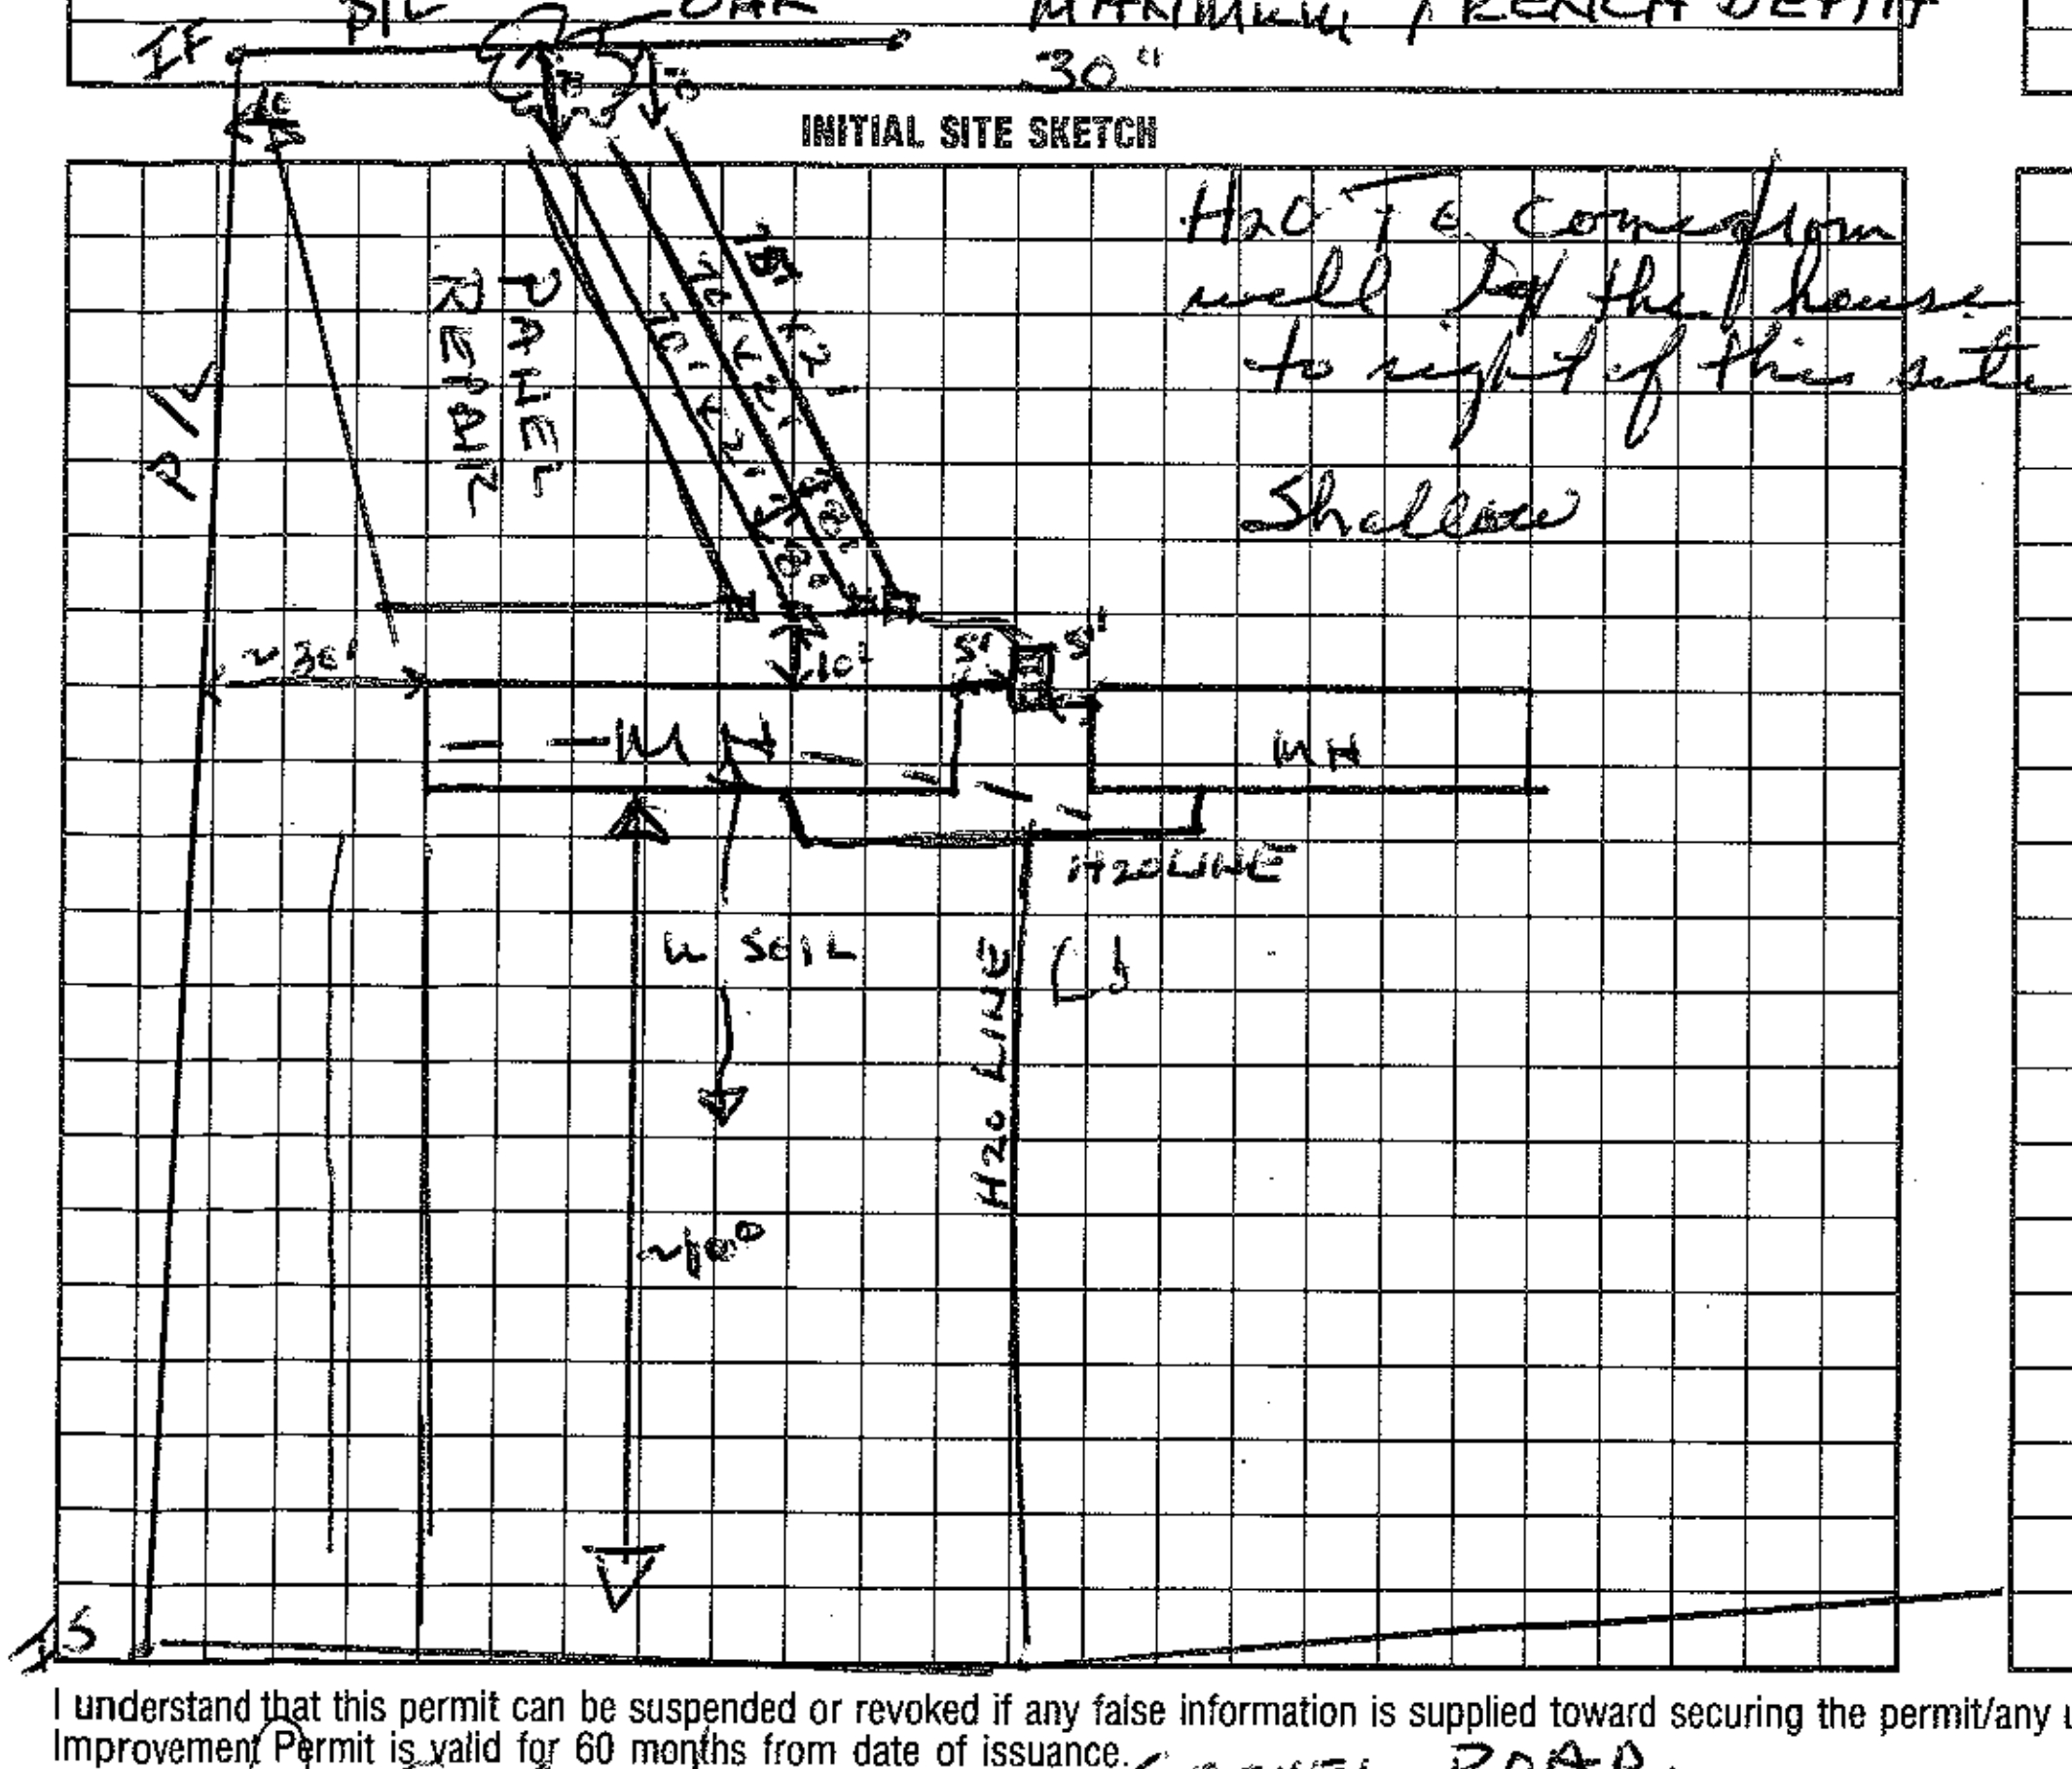

AS BUILT SKETCH

I understand that this permit can be suspended or revoked if any false information is supplied toward securing the permit/any unauthorized changes are made to the site/any unauthorized changes are made in the installation of the system. Improvement Permit is valid for 60 months from date of issuance.

Signed: Paul Combs

Installed by: Tim Simmons

Improvement Permit by: Wesley Sparks R.S. date 10/17/94

Certificate of Completion by: ______ date ______

Existing System Inspection by: Construct! Wesley Sparks RS date 10/24/95

Operation Permit by: Wesley Sparks R.S. date 10/24/95

HEALTH DEPT. COPY: WHITE INSPECTION COPY (FINAL): GREEN OWNER COPY (FINAL): YELLOW INSPECTION COPY (INITIAL): PINK OWNER COPY (INITIAL): GOLD