IREDELL COUNTY HEALTH DEPARTMENT

STATESVILLE 704-878-5305 MOORESVILLE 704-664-5281

IMPROVEMENT PERMIT / AUTHORIZATION TO CONSTRUCT / OPERATION PERMIT / EXISTING SYSTEM INSPECTION

PERMIT# 131 390 PIN# 4658971173 / Angela Butch DATE 10/5/05

OWNER OR CONTRACTOR America's Home Place / Martha PHONE: Business 664-5800 Home

ADDRESS 168-D Norman Station Blvd Mooresville NC

LOCATION Hwy 115 North TR Shingrille Rd TR Little Creek on right #128 Little Creek

SUBDIVISION Dan J Martin BLOCK / SECTION LOT 2 LOT AREA .85 Acre SITE CLASS. DESIGN FLOW 360 gpd L.T.A.R.

Septic ~~Exist~~ 1000 Gallons; STB Date

Pump Tank: Gallons; PT Date

Pump Make: Model Serial No.

Nitrification Field: No Fields 1 Square Feet 1200 Linear Feet 400'

EXIST No Lines 4@100' Trench Width 36" Max Trench Bottom Depth 36" Gravel Depth 12"

☐ New System ☐ Repair System Type: I, II, III, IV, V, VI

System Description: EXIST Grav. Conventional

Repair System Description: Same

Maintenance Agreement Required: ☐ Yes ☒ No

☒ House/Mod. Home No. Bedrooms 3

☐ Mobile Home No. Bathrooms 2

☐ Business No. Employees

☐ Other


☐ Slab ☒ Crawl Space ☐ Basement w/plumbing ☐ Basement wo/plumbing

Water Supply: ☐ Individual ☐ Public ☐ Community


Comments:/Conditions: Existing Septic System appeared to be functioning okay at time of inspection, no problems noticed.

Comments:/Conditions: * Well not installed at time of inspection.

INITIAL SITE SKETCH * Not to Scale

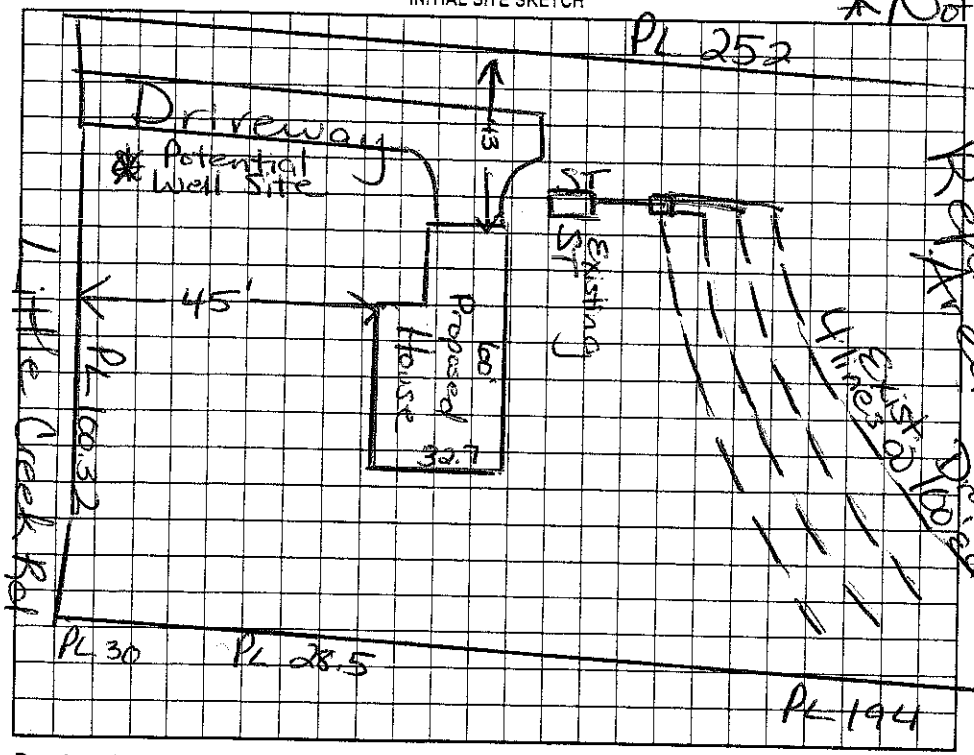

AS BUILT SKETCH

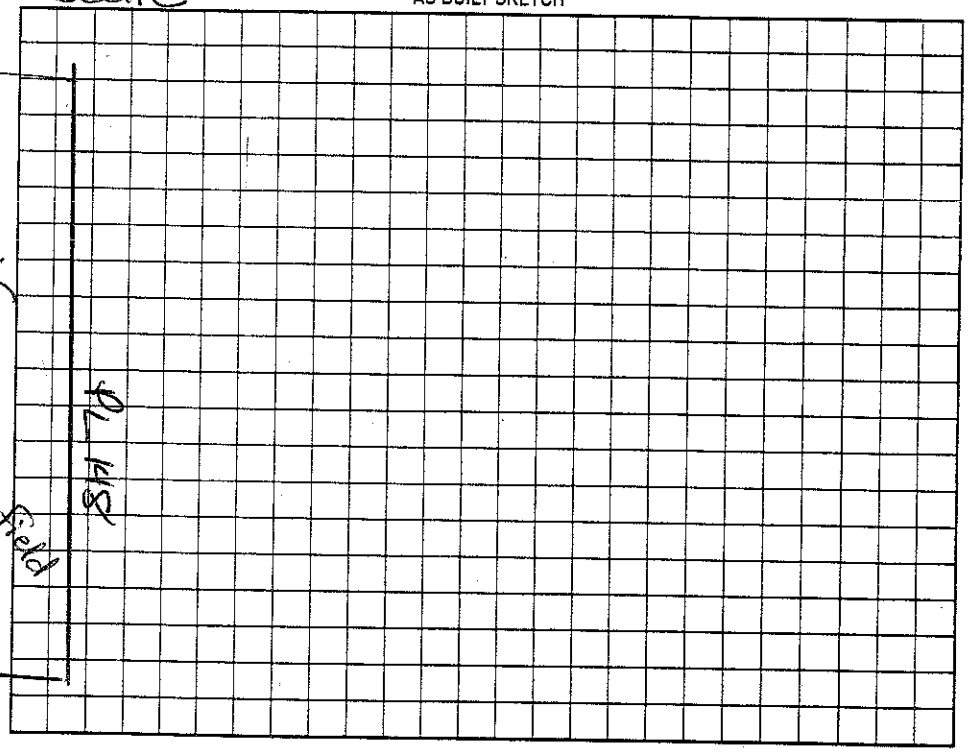

Permit can be suspended or revoked if any false information is supplied toward securing the permit/any unauthorized changes are made to the site/any unauthorized changes are made in the installation of the system. Improvement Permit with plat valid without expiration. Improvement Permit with site plan valid for sixty months. Authorization to Construct is valid for a period equal to that of Improvement Permit – not to exceed sixty months.

Signed: Allo Bayer date 10/7/05 Installed by:

Improvement Permit by: Maria H. Dotson RS date 10/7/05 Operation Permit by: date

Authorization to Construct by: Maria H. Dotson RS date 10/7/05 Existing System Inspection by: Maria H. Dotson date 10/7/05

HEALTH DEPT. COPY: WHITE OWNER COPY (FINAL): YELLOW OWNER COPY (INITIAL): PINK