IREDELL COUNTY HEALTH DEPARTMENT

STATESVILLE 704-878-5305 MOORESVILLE 704-664-5281

IMPROVEMENT PERMIT / AUTHORIZATION TO CONSTRUCT / OPERATION PERMIT / EXISTING SYSTEM INSPECTION

PERMIT# 103120 PIN# 4658 97 2032

OWNER OR CONTRACTOR Angela N. Martin DATE 12/14/01

ADDRESS 128 Little Creek Rd. Mooresville, NC, 28115 PHONE: Business Home 704-663-6293

LOCATION 115 N TR Statesville Rd TR Little Creek Dr. to lot on (R)

SUBDIVISION No BLOCK / SECTION LOT No LOT AREA SITE CLASS. PS DESIGN FLOW 360 L.T.A.R. .3

Septic Tank: 1000 Gallons; STB Date 2/5/02

Pump Tank: Gallons; PT Date

Pump Make: Model Serial No.

Nitrification Field: No Fields 1 Square Feet 1200 Linear Feet 400

No Lines 4 @ 100' Trench Width 3' Max Trench Bottom Depth 3' Gravel Depth 12"

X New System ☐ Repair System Type: I, (II), III, IV, V, VI

System Description: GRAV - CONVENTIONAL

Repair System Description: SAME

Maintenance Agreement Required: ☐ Yes ☒ No

☐ House/Mod. Home ☒ Mobile Home ☐ Business ☐ Other

No. Bedrooms 3 No. Bathrooms 2 No. Employees


Water Supply: ☒ Individual ☐ Public ☐ Community

☐ Slab ☐ Crawl Space ☐ Basement w/plumbing ☐ Basement wo/plumbing


Comments:/Conditions:

Comments:/Conditions:

INITIAL SITE SKETCH

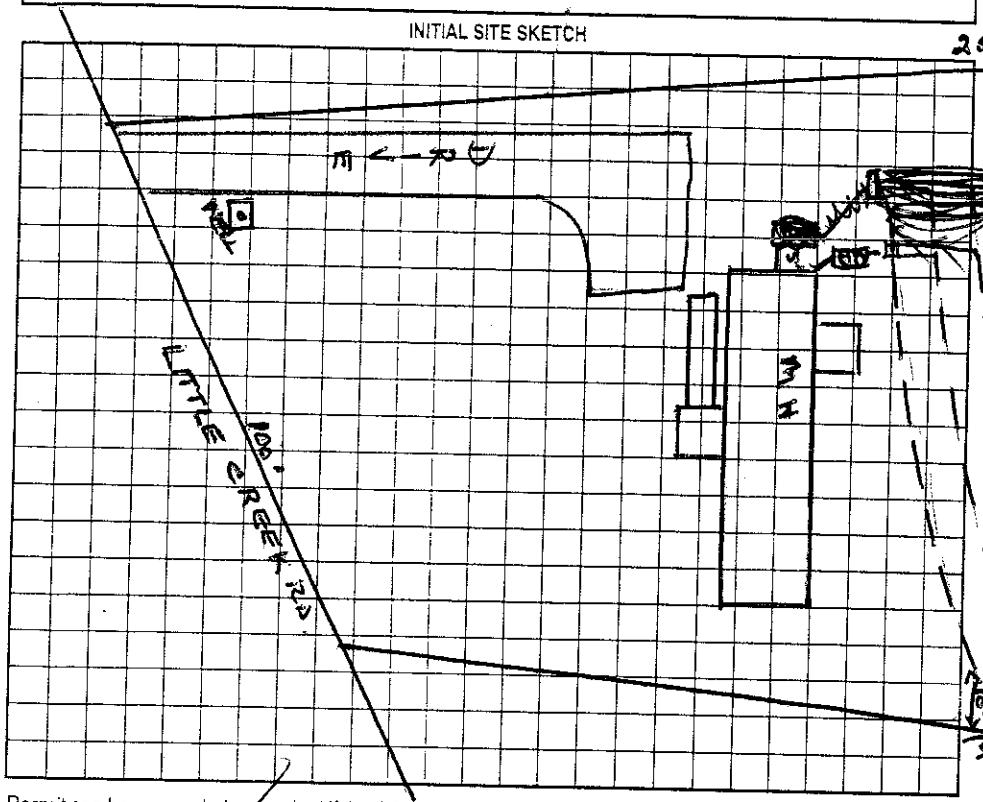

AS BUILT SKETCH

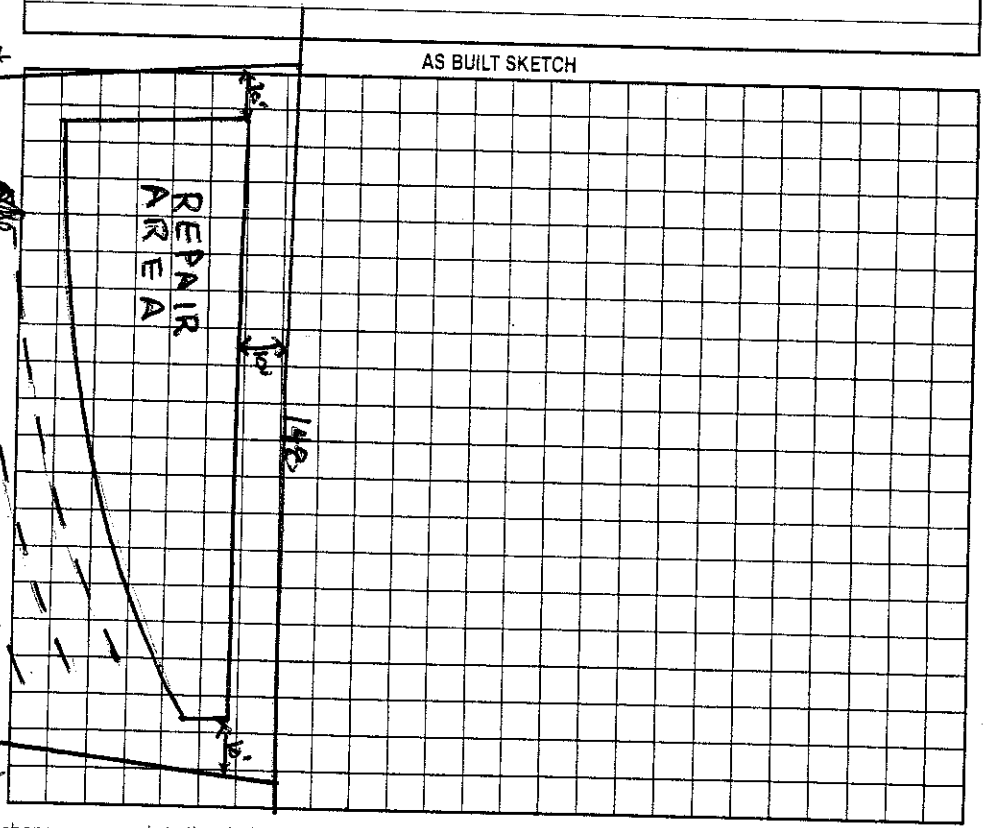

Permit can be suspended or revoked if any false information is supplied toward securing the permit/any unauthorized changes are made to the site/any unauthorized changes are made in the installation of the system. Improvement Permit with plat valid without expiration. Improvement Permit with site plan valid for sixty months. Authorization to Construct is valid for a period equal to that of Improvement Permit – not to exceed sixty months.

Signed: [signature] date 1/15/02

Improvement Permit by: Wesley Sparks RS. date 12/14/01

Authorization to Construct by: Wesley Sparks RS date 12/14/01

Installed by: Wayne Country

Operation Permit by: Wesley Sparks RS. date 3/15/02

Existing System Inspection by: date

HEALTH DEPT COPY WHITE