4058980708

IREDELL COUNTY HEALTH DEPARTMENT

STATESVILLE 704-878-5305 MOORESVILLE 704-664-5281

IMPROVEMENT PERMIT / CERTIFICATE OF COMPLETION / OPERATION PERMIT / EXISTING SYSTEM INSPECTION

PROPERTY DESCRIPTION NO. 16773 DATE 11/23/93 TAX MAP NO. 10 1A 85+86 Watershed: ☑ Yes ☐ No

OWNER OR CONTRACTOR RANDY OVERCASH PHONE: Business _____ Home 663-6421

ADDRESS Rt 5 Box 536 MOORESVILLE, NC. 28115

LOCATION SHINNVILLE RD ~1000 FT. ONE

SUBDIVISION WALTER E SHERRILL BLOCK / SECTION _____ LOT 85+86 LOT AREA ~ 7AC. SITE CLASS. P DESIGN FLOW 360 L.T.A.R. .25

Septic Tank: 1000 Gallons; STB 825 Date 1-21-94

Pump Tank: _____ Gallons; PT _____ Date _____

Pump Make: _____ Model _____ Serial No. _____

Nitrification Field: No Fields 1 Square Feet 1440 Linear Feet 480

No Lines 4 Trench Width 3' Max Trench Bottom Depth 36" Gravel Depth _____

☑ New System ☐ Repair System Type: I II III, IV, V, VI

System Description: CONV - DIST. BOX

Repair System Description: CONV.

Maintenance Agreement Required: ☐ Yes ☑ No

☑ House/Mod. Home No. Bedrooms 3

☐ Mobile Home No. Bathrooms 2.5

☐ Business No. Employees _____

☐ Other _____


☐ Slab ☑ Crawl Space ☐ Basement w/plumbing ☐ Basement wo/plumbing

Water Supply: ☑ Individual ☐ Community ☐ Public


Comments: TRENCHES 36" DEEP TO TRENCH BOTTOM ON SLOPE CONTOUR IN DIRECTION SHOWN.

Comments:

INITIAL SITE SKETCH

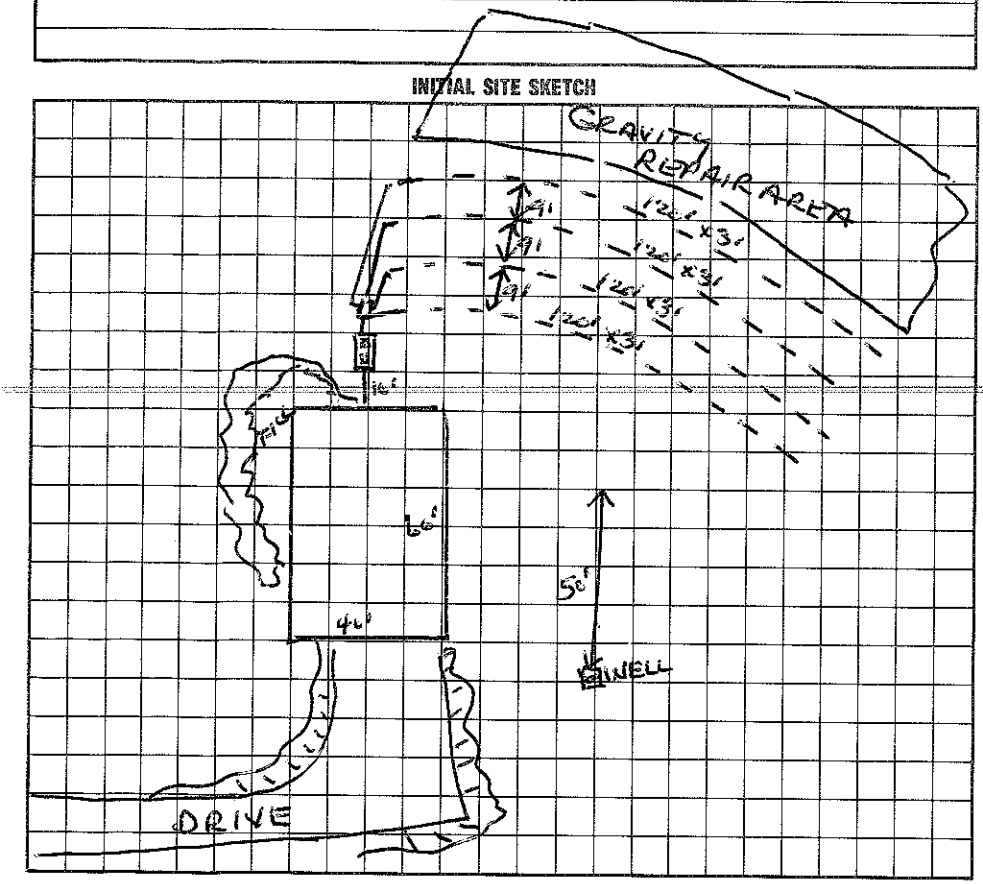

AS BUILT SKETCH

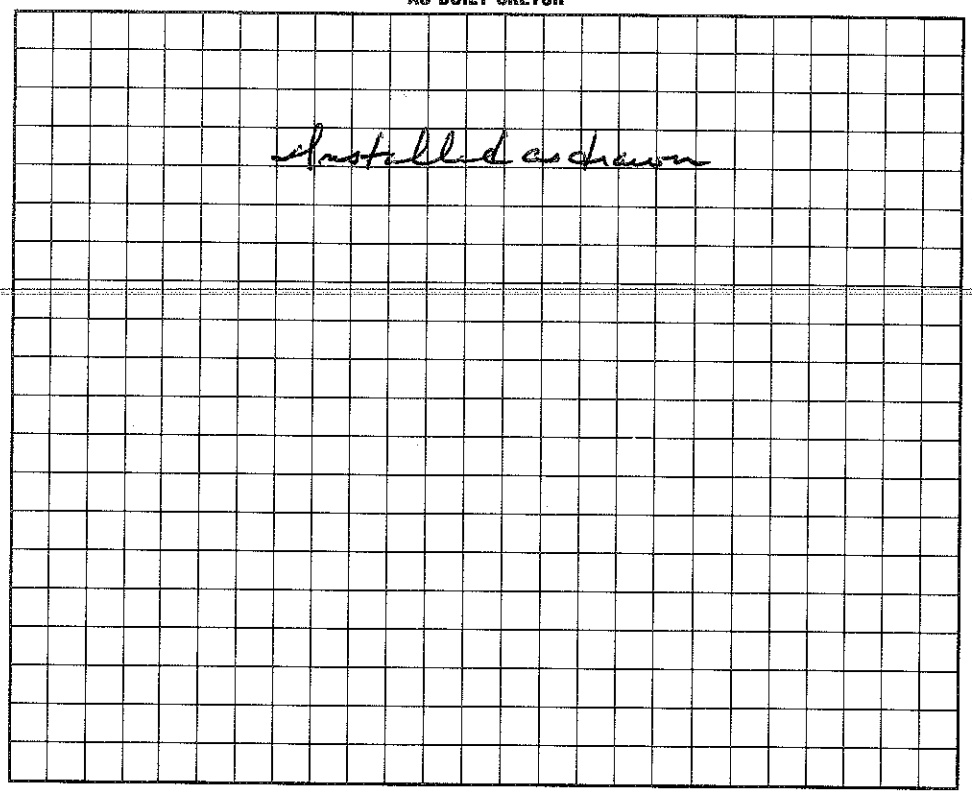

I understand that this permit can be suspended or revoked if any false information is supplied toward securing the permit/any unauthorized changes are made to the site/any unauthorized changes are made in the installation of the system. Improvement Permit is valid for 60 months from date of issuance.

Signed: Randy Overcash

Improvement Permit by: Wesley Sparks RS. date 11/23/93

Existing System Inspection by: _____ date _____

Installed by: Rowan Septic Tank

Certificate of Completion by: Wesley Sparks RS. date 4/5/94

Operation Permit by: _____ date _____

HEALTH DEPT. COPY: WHITE INSPECTION COPY (FINAL): GREEN OWNER COPY (FINAL): YELLOW INSPECTION COPY (INITIAL): PINK OWNER COPY (INITIAL): GOLD