IREDELL COUNTY HEALTH DEPARTMENT

Statesville Office (704) 878-5305 Mooresville Office (704) 660-3625 PERMIT # 216630

IMPROVEMENT PERMIT / AUTHORIZATION TO CONSTRUCT / OPERATION PERMIT / EXISTING SYSTEM

PIN # 4658-98-0708.000

APPLICANT: Jasper Builders Inc. APPLICANT ADDRESS: 181 W Statesville Ave. Mooresville NC 28115

SITE ADDRESS: 187 Shinnville Rd., Mooresville NC, 28115 PHONE: 704-799-9982 ALT. PHONE: 704-254-6190

SITE DIRECTIONS: Hwy 115 N, TR Shinnville, Site on L

SUBDIVISION: — SECTION: — LOT # — LOT AREA: 11.878 Acre DESIGN FLOW: Ex. 480 GPD L.T.A.R.: Existing

Septic Tank Existing (gal) STB Date
Pump Tank (gal) PT Date
Pump Make Model Serial #
Nitrification Fields Ex. # Lines Ex. Linear Ft: Ex.
Trench Width Ex. Max. Trench Bottom Depth Ex. Gravel Depth Ex.

☐ New System ☐ Repair ☐ Expansion System Type: I II ☒ IV V VI
System Description: Existing - 25% Red. - Gravity
Repair System Description: 25% Reduction - Gravity
Maintenance Agreement Required: ☐ YES ☒ NO
☒ GRAVITY ☐ PRESSURE


☒ Residence ☐ Business ☐ Other ☐ Slab ☐ Basement w/plumbing
No. Bedrooms Ex. 4 No. Persons Ex. 8 No. Employees
☒ Crawl Space ☐ Basement w/o plumbing

Water Supply: ☒ Private ☐ Public ☐ Community

Comments / Conditions: This Permit is for the Approval of Proposed Cabana. This Structure Meets Setbacks from Septic & Well. Existing System Appeared To Be Functioning @ Time of Inspection.

INITIAL SITE SKETCH

AS BUILT SKETCH

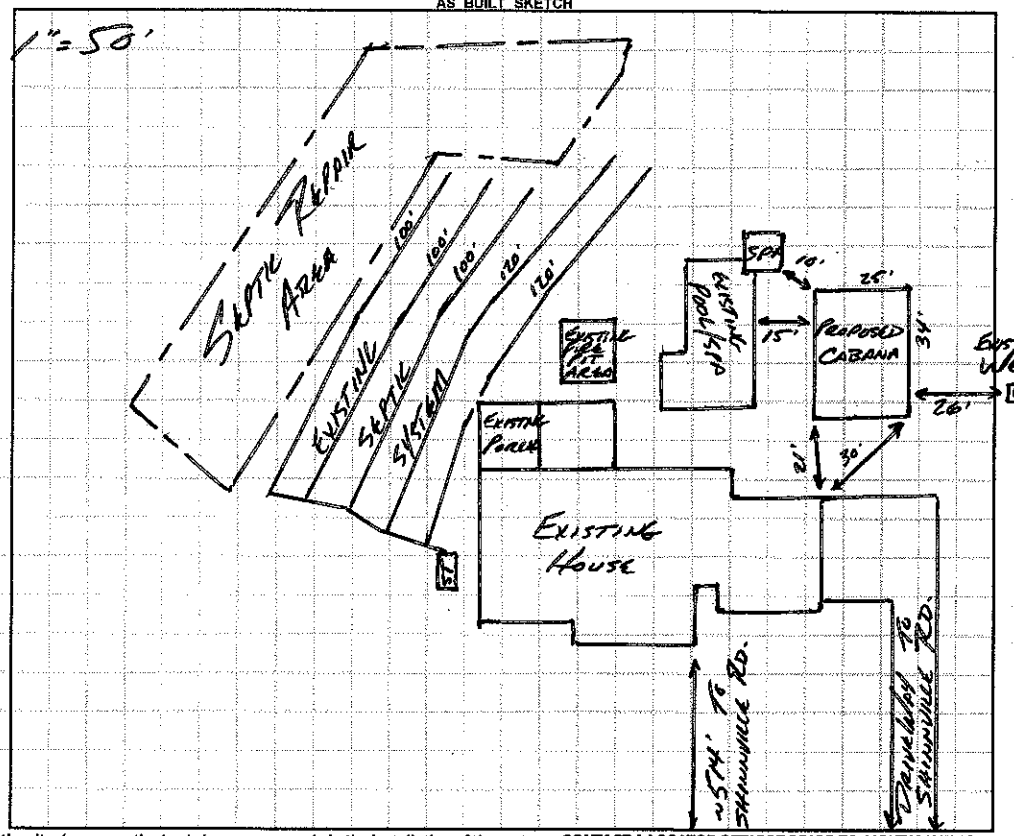

Permit can be suspended or revoked if any false information is supplied toward securing the permit / any unauthorized changes are made to the site / any unauthorized changes are made in the installation of the system. **CONTACT A LOCATOR SERVICE PRIOR TO ANY EXCAVATION**

☐ **IMPROVEMENT PERMIT** ***with plat*** *valid without expiration.* ☐ **IMPROVEMENT PERMIT** ***with site plan*** *valid for 60 mos.* ☐ **AUTHORIZATION TO CONSTRUCT** *valid for period equal to IMPROVEMENT PERMIT--not to exceed 60 mo.*

Owner / Applicant Signature: Date: 3/11/16 Installed by:

IMPROVEMENT PERMIT by: Date: OPERATION PERMIT by: Date:

AUTHORIZATION TO CONSTRUCT by: Date: Existing System Inspected by: APPROVED MAR 07 2016

Health Dept. Copy - WHITE Applicant (Final Approval) - YELLOW Applicant (Conditional Approval) - PINK