IREDELL COUNTY HEALTH DEPARTMENT

Statesville Office (704) 878-5305 Mooresville Office (704) 660-3625 PERMIT # 200573

IMPROVEMENT PERMIT / AUTHORIZATION TO CONSTRUCT / OPERATION PERMIT / EXISTING SYSTEM

PIN # 4658-98-0708

APPLICANT: Jasper Builders / Scott Plemmons APPLICANT ADDRESS: 181 W. Statesville Ave Mooresville 28115

SITE ADDRESS: 187 Shinnville Rd Mooresville NC 28115 PHONE: 704-799-9982 ALT. PHONE:

SITE DIRECTIONS: Hwy 115 N, TR on Shinnville Rd, Lot on L

SUBDIVISION: SECTION: LOT # LOT AREA: 11.878 ac DESIGN FLOW: 480 gpd L.T.A.R.: 0.25

Septic Tank 1000 (gal) STB 794 Date 1-13-14
Pump Tank (gal) PT Date
Pump Make Model Serial #
Nitrification Fields 1 # Lines 3 Linear Ft: 300
Trench Width 36" Max. Trench Bottom Depth 36" Gravel Depth N/A


☐ New System ☐ Repair ☑ Expansion System Type: I II (III) IV V VI
System Description: Gravity 25% Reduction
Repair System Description: Gravity 25% Reduction
Maintenance Agreement Required: ☐ YES ☑ NO
☑ GRAVITY ☐ PRESSURE

☑ Residence ☐ Business ☐ Other ☐ Slab ☐ Basement w/plumbing
No. Bedrooms 4 No. Persons 8 No. Employees
☑ Crawl Space ☐ Basement w/o plumbing

Water Supply: ☑ Private ☐ Public ☐ Community

Comments / Conditions: * Install lines 36" Deep * Add new drop boxes to ends of existing gravel lines, existing tank to be pumped, crushed and backfilled or removed, abandoned lines can be removed or left

INITIAL SITE SKETCH

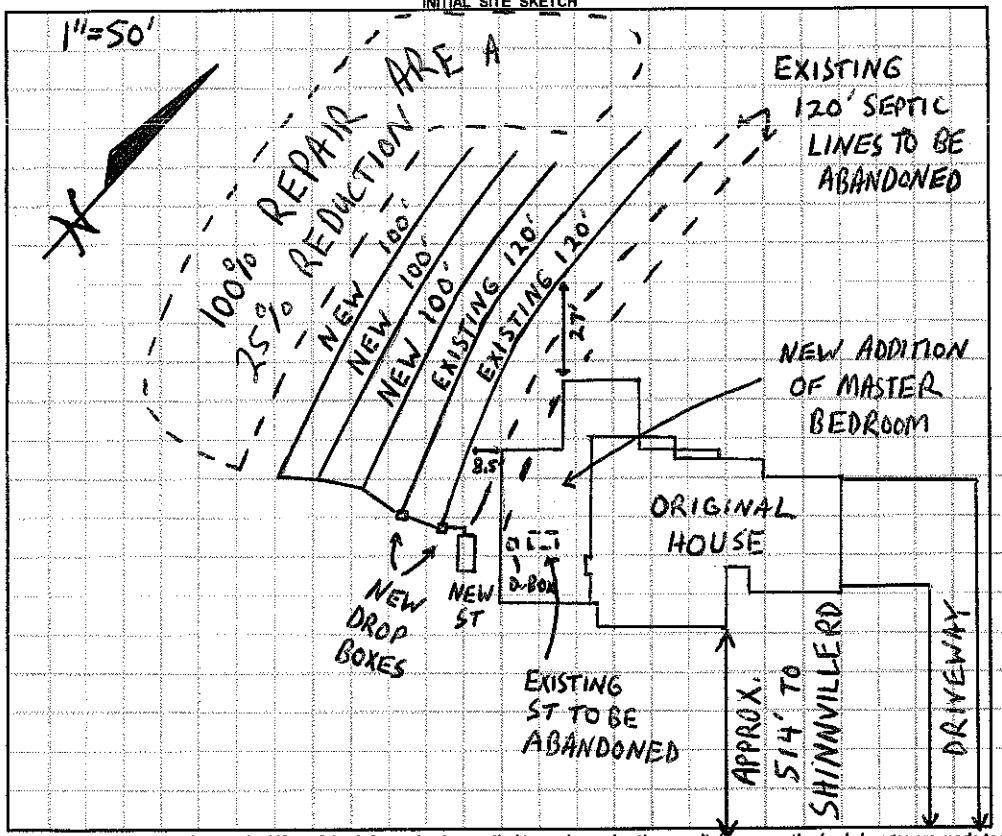

AS BUILT SKETCH

* Installed Infiltrator Chambers Quick 4

Permit can be suspended or revoked if any false information is supplied toward securing the permit / any unauthorized changes are made to the site / any unauthorized changes are made in the installation of the system. **CONTACT A LOCATOR SERVICE PRIOR TO ANY EXCAVATION**

☐ **IMPROVEMENT PERMIT** *with plat valid without expiration.* ☑ **IMPROVEMENT PERMIT** *with site plan valid for 60 mos.* ☑ **AUTHORIZATION TO CONSTRUCT** *valid for period equal to IMPROVEMENT PERMIT--not to exceed 60 mo.*

Owner / Applicant Signature: Date: 2-10-14 Installed by: Richard Abernathy

IMPROVEMENT PERMIT by: Chris L. Pruett Date: 2-4-14 OPERATION PERMIT by: Date: 2-20-14

AUTHORIZATION TO CONSTRUCT by: Chris L. Pruett Date: 2-4-14 Existing System Inspected by: Date:

Health Dept. Copy - WHITE Applicant (Final Approval) - YELLOW Applicant (Conditional Approval) - PINK