IREDELL COUNTY HEALTH DEPARTMENT

STATESVILLE 704-878-5305 MOORESVILLE 704-664-5281

IMPROVEMENT PERMIT / AUTHORIZATION TO CONSTRUCT / OPERATION PERMIT / EXISTING SYSTEM INSPECTION

PERMIT# 090920 PIN# 4658 99 5249 Pt. 4658-98-2954 DATE 12/3/02

OWNER OR CONTRACTOR JEAN SCAUGHTER PHONE: Business Home 704-651-1283

ADDRESS 1040 CHARLOTTEE HWY TROUTMAN 28166 140 BARNSWALLOW CT.

LOCATION 115N TR SHINNVILLE RD. TL CAROLINA WREN TL BARNSWALLOW AT CUL DE SAC

SUBDIVISION GRACE MEADOWS BLOCK / SECTION LOT 23 LOT AREA 725000 FT² SITE CLASS. PS DESIGN FLOW 480 L.T.A.R. .3

Septic Tank: 1000 Gallons; STB 1012 Date 6/3/02
Pump Tank: 1000 Gallons; PT 17 Date 9/9/02
Pump Make: Goulds Model WE6-511H Serial No. L-025844
Nitrification Field: No Fields 1 Square Feet 536 Linear Feet 268
No Lines 4@67 Trench Width 2' Max Trench Bottom Depth 3' Gravel Depth No

[X] New System [ ] Repair System Type: I, II, III, IV, V, VI
System Description: Pressure Dosed - 16" PPBPS
Repair System Description: SAME
Maintenance Agreement Required: [X] Yes [ ] No


[X] House/Mod. Home No. Bedrooms 4
[ ] Mobile Home No. Bathrooms 3
[ ] Business No. Employees
[ ] Other
[ ] Slab [X] Crawl Space [ ] Basement w/plumbing [ ] Basement wo/plumbing

Water Supply: [X] Individual [ ] Public [ ] Community

Comments:/Conditions: WELL MUST BE INSTALLED AS DRAWN HERE - 100' SEPARATION REQUIRED BETWEEN WELLS AND SEPTIC TANK SYSTEMS
50% REDUCED SYSTEM

Comments:/Conditions: 62

INITIAL SITE SKETCH

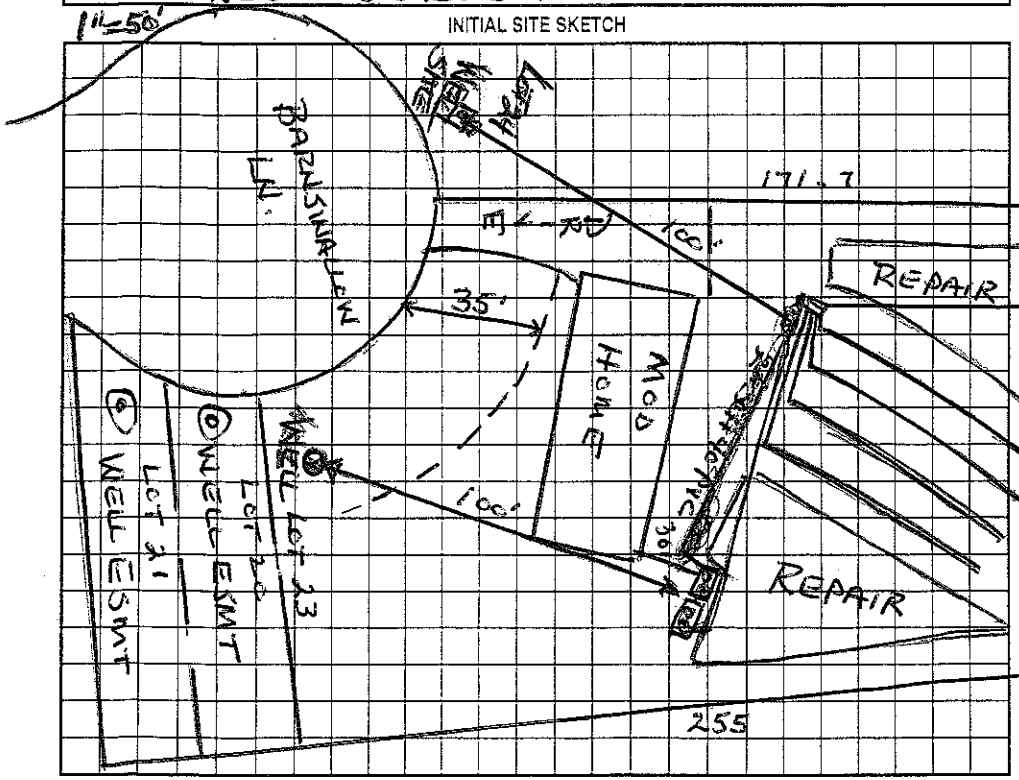

AS BUILT SKETCH

Permit can be suspended or revoked if any false information is supplied toward securing the permit/any unauthorized changes are made to the site/any unauthorized changes are made in the installation of the system. Improvement Permit with plat valid without expiration. Improvement Permit with site plan valid for sixty months. Authorization to Construct is valid for a period equal to that of Improvement Permit – not to exceed sixty months.

Signed: [signature] date 12/3/02 Installed by: A-1 Backhoe

Improvement Permit by: Wesley Sparks R.S. date 12/3/02 Operation Permit by: Wesley Sparks R.S. date 1/21/03

Authorization to Construct by: Wesley Sparks R.S. date 12/3/02 Existing System Inspection by: date

HEALTH DEPT. COPY: WHITE OWNER COPY (FINAL): YELLOW OWNER COPY (INITIAL): PINK

IREDELL COUNTY HEALTH DEPARTMENT

STATESVILLE 704-878-5305 MOORESVILLE 704-664-5281

IMPROVEMENT PERMIT / AUTHORIZATION TO CONSTRUCT / OPERATION PERMIT / EXISTING SYSTEM INSPECTION

PERMIT# 090920 PIN# 4658 99 5249 Pt. 4658-98-2954 DATE 12/3/02

OWNER OR CONTRACTOR JEAN SLAUGHTER PHONE: Business Home 704-651-1283

ADDRESS 1040 CHARLOTTEE HWY TROUTMAN 28166 140 BARNSWALLOW CT.

LOCATION 115N TR SHINNVILLE RD. TL CAROLINA WREN TL BARNSWALLOW AT CUL DE SAC

SUBDIVISION GRACE MEADOWS BLOCK / SECTION LOT 23 LOT AREA 725000 FT² SITE CLASS. PS DESIGN FLOW 480 L.T.A.R. .3

Septic Tank: 1000 Gallons; STB 1012 Date 12/3/02
Pump Tank: 1000 Gallons; PT 17 Date 9/9/02
Pump Make: Gould Model WE-STIH Serial No 2L-02L5844
Nitrification Field: No Fields 1 Square Feet 536 Linear Feet 268
No Lines 4@67 Trench Width 2' Max Trench Bottom Depth 3' Gravel Depth NO

☒ New System ☐ Repair System Type: I. II. III. IV. V. VI
System Description: PreDosed - 16" PPBPS
Repair System Description: SAME
Maintenance Agreement Required: ☒ Yes ☐ No


☒ House/Mod. Home No. Bedrooms 4
☐ Mobile Home No. Bathrooms 3
☐ Business No. Employees
☐ Other
☐ Slab ☒ Crawl Space ☐ Basement w/plumbing ☐ Basement wo/plumbing

Water Supply: ☒ Individual ☐ Public ☐ Community


Comments/Conditions: WELL MUST BE INSTALLED AS DRAWN HERE - 100' SEPARATION REQUIRED BETWEEN WELLS AND SEPTIC TANK SYSTEMS
50% REDUCED SYSTEM

Comments/Conditions: 62

INITIAL SITE SKETCH

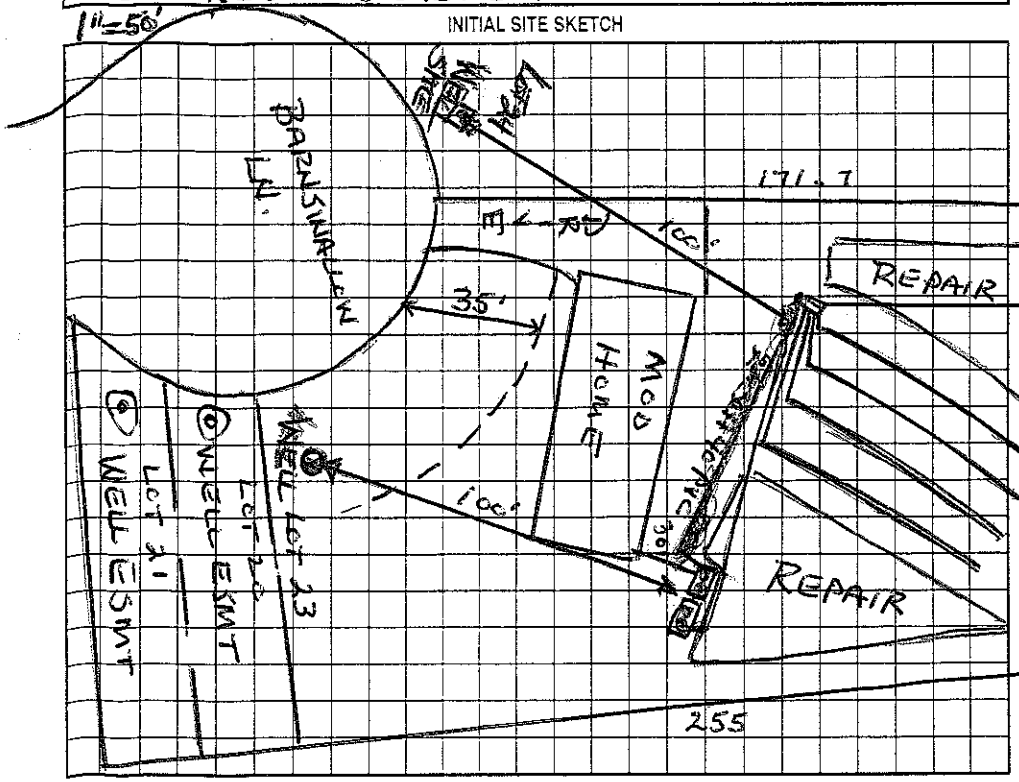

AS BUILT SKETCH

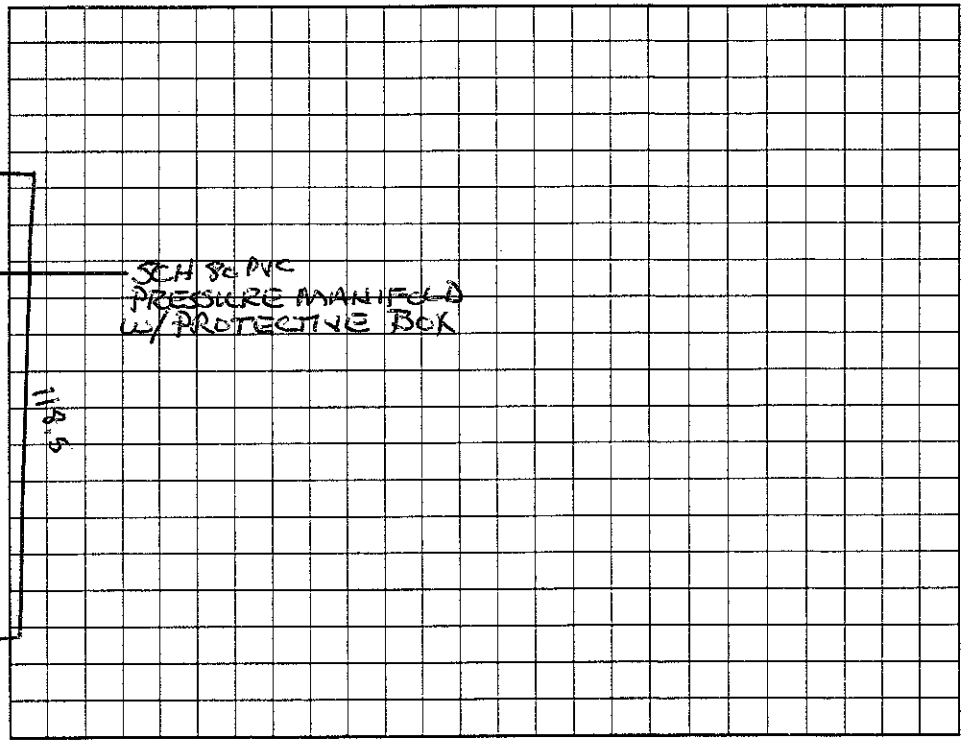

Permit can be suspended or revoked if any false information is supplied toward securing the permit/any unauthorized changes are made to the site/any unauthorized changes are made in the installation of the system. Improvement Permit with plat valid without expiration. Improvement Permit with site plan valid for sixty months. Authorization to Construct is valid for a period equal to that of Improvement Permit – not to exceed sixty months.

Signed: [signature] date 12/3/02 Installed by: A-1 Backhoe

Improvement Permit by: Wesley Sparks R.S. date 12/3/02 Operation Permit by: Wesley Sparks R.S. date 1/24/03

Authorization to Construct by: Wesley Sparks R.S. date 12/3/02 Existing System Inspection by: date

HEALTH DEPT. COPY: WHITE OWNER COPY (FINAL): YELLOW OWNER COPY (INITIAL): PINK