IREDELL COUNTY HEALTH DEPARTMENT

STATESVILLE 704-878-5305 Paid / 125.00 IP MOORESVILLE 704-664-5281

IMPROVEMENT PERMIT / AUTHORIZATION TO CONSTRUCT / OPERATION PERMIT / EXISTING SYSTEM INSPECTION

PERMIT# 090921 PIN# 4658995249 (pt.) 4658-98-3717VJ DATE Dec. 4, 00

OWNER OR CONTRACTOR Mid Carolina Dev (Ronald Regula) PHONE: Business 634-0173 Home

ADDRESS P.O. Box 1580 Cornelius N.C. 28031

LOCATION 115N TR Shinnville Rd. TL Carolina Wren TL Barnswallow at End

SUBDIVISION Grace Meadows BLOCK / SECTION LOT 24 LOT AREA 35,203 ft² SITE CLASS. PS DESIGN FLOW 360 gpd L.T.A.R. 0.3

Septic Tank: 1000 Gallons; STB 794 Date 3/3/01
Pump Tank: 1000 Gallons; PT 27 Date 3/3/01
Pump Make: Hydromatic Model SHEF-50A Serial No. 9/99
Nitrification Field: No Fields 1 Square Feet 1200 Linear Feet 400
No Lines 4 @ 100 Trench Width 36" Max Trench Bottom Depth 36" Gravel Depth 12"

☒ New System ☐ Repair System Type: I, II, (III), IV, V, VI
System Description: pm - Conventional
Repair System Description: pm Innovative -25% Red
Maintenance Agreement Required: ☐ Yes ☒ No
☐ Slab ☒ Crawl Space ☐ Basement w/plumbing ☐ Basement wo/plumbing

☒ House/Mod. Home No. Bedrooms 3
☐ Mobile Home No. Bathrooms 2
☐ Business No. Employees
☐ Other


Water Supply:
☒ Individual
☐ Public
☐ Community

Comments:/Conditions: Install well exactly where shown. Maintain 100' between well & septic system.

Comments:/Conditions:

INITIAL SITE SKETCH

1" = 50'

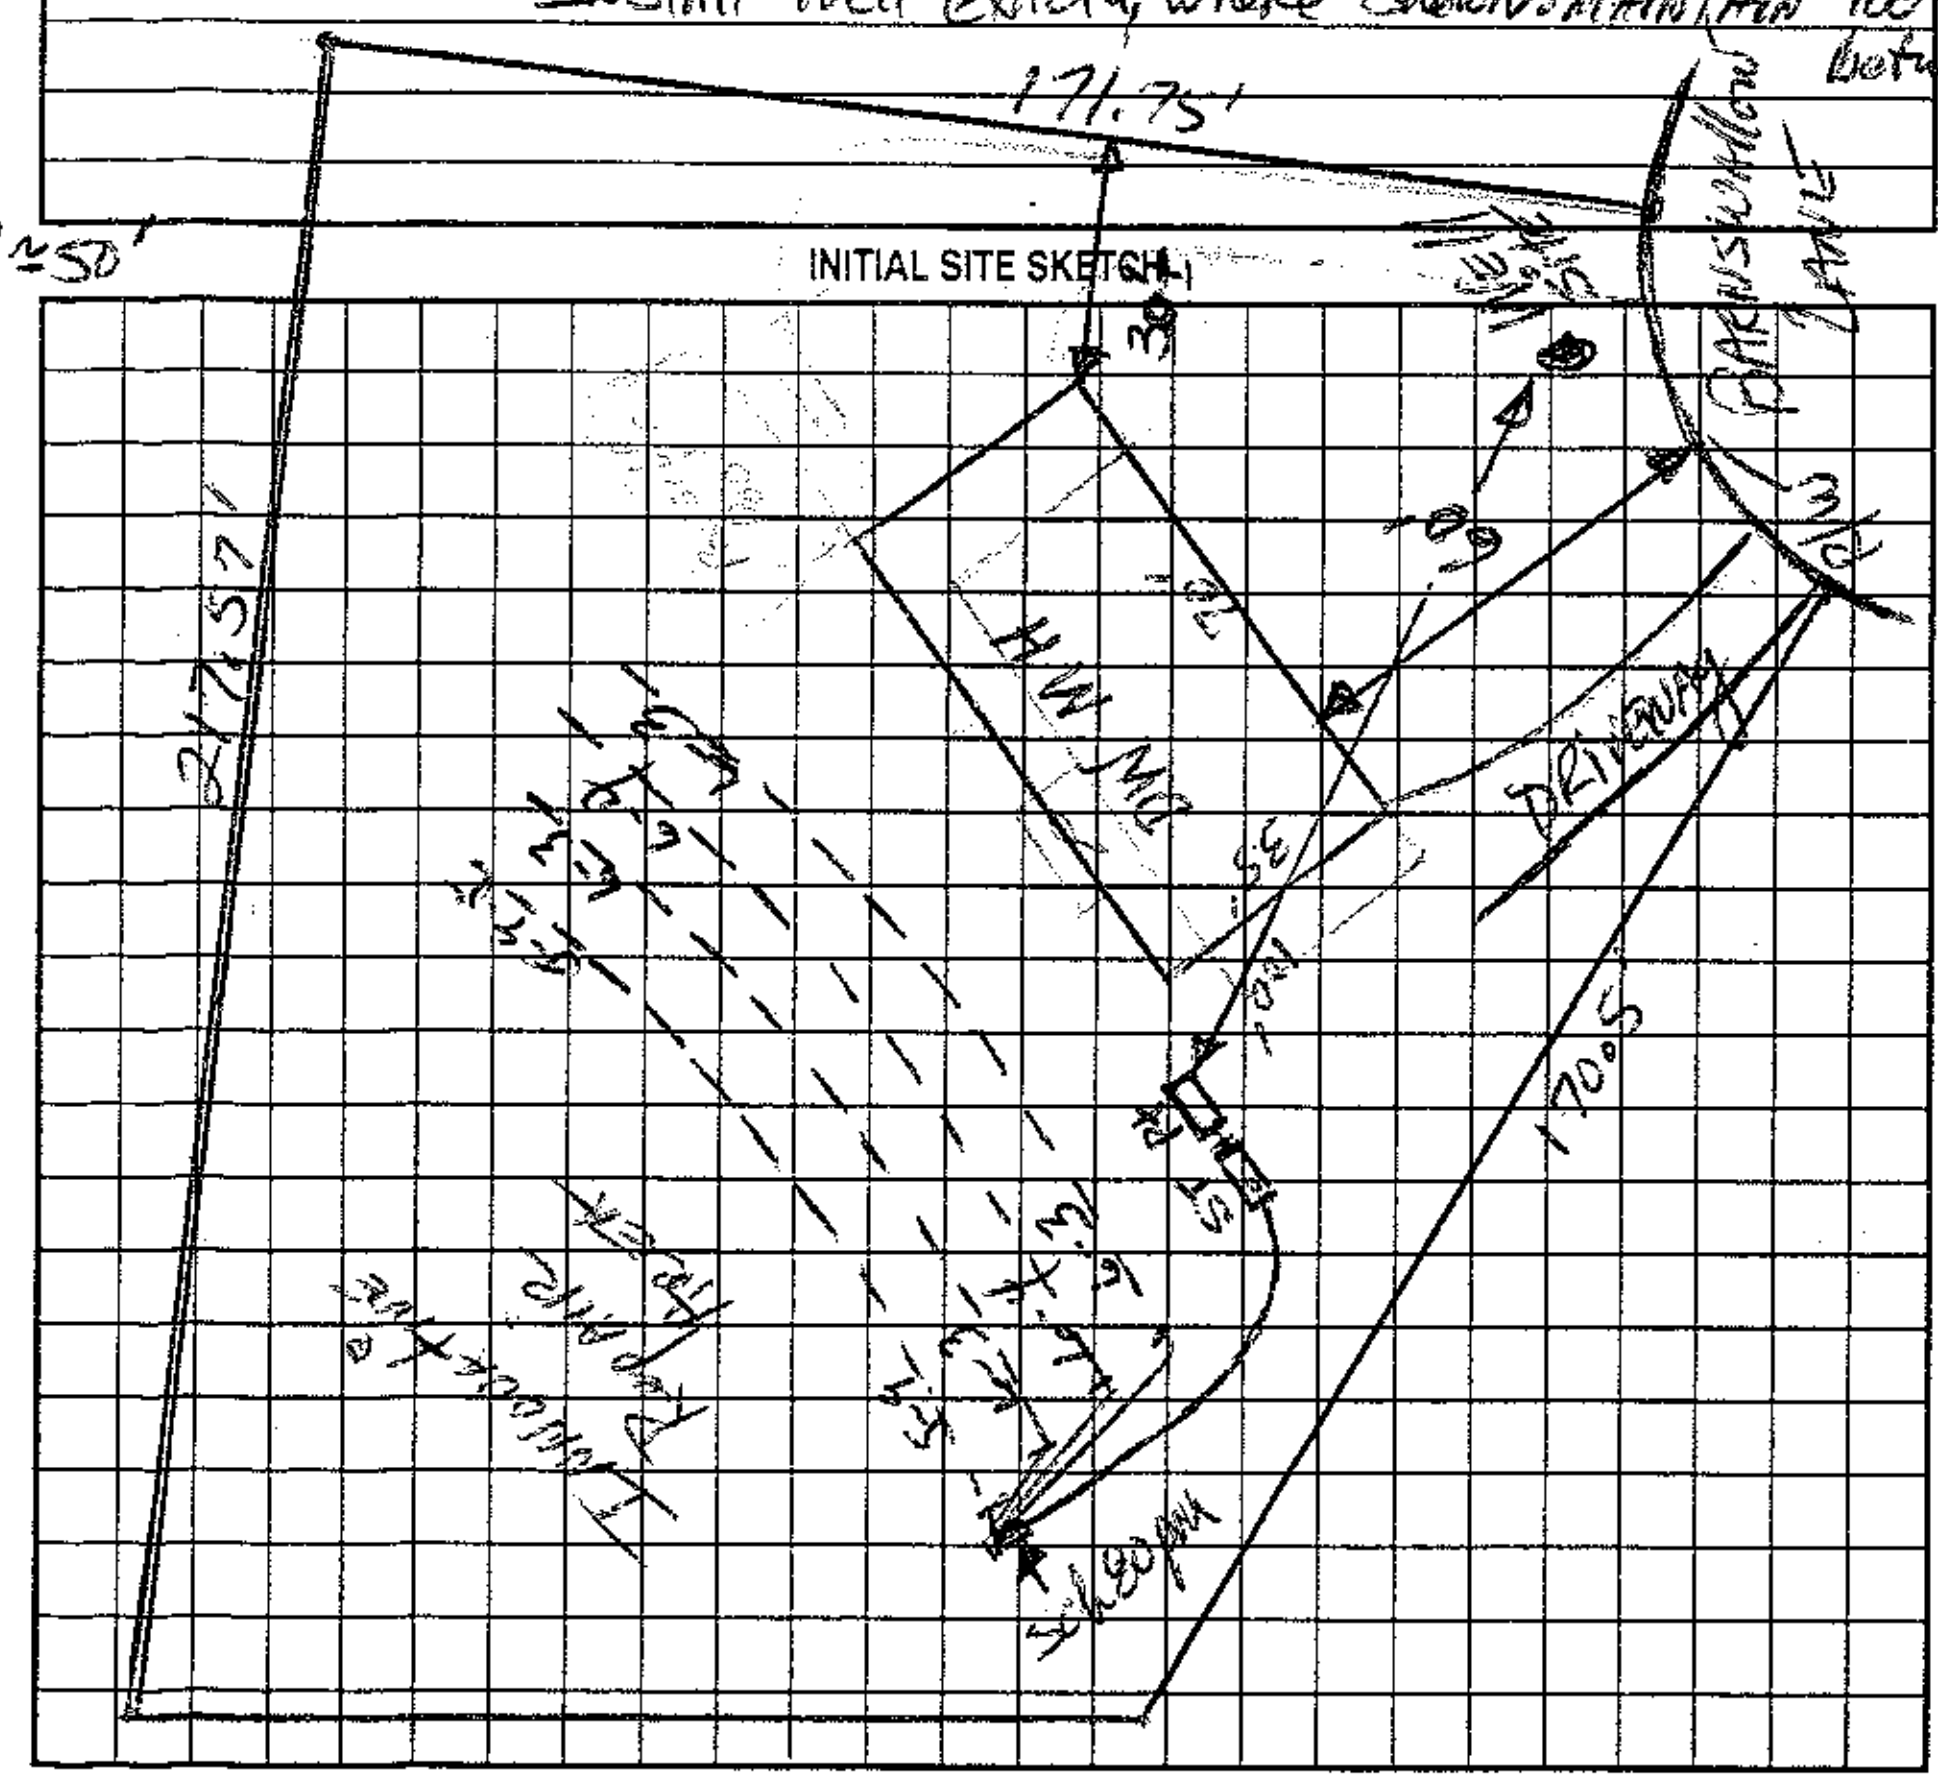

AS BUILT SKETCH

Permit can be suspended or revoked if any false information is supplied toward securing the permit/any unauthorized changes are made to the site/any unauthorized changes are made in the installation of the system. Improvement Permit with plat valid without expiration. Improvement Permit with site plan valid for sixty months. Authorization to Construct is valid for a period equal to that of Improvement Permit – not to exceed sixty months.

Signed: [signature] date 12-5-00 Installed by: Craig Thompson

Improvement Permit by: [signature] RS date 12-4-00 Operation Permit by: Wesley Sparks R.S. date 5/18/01

Authorization to Construct by: Wesley Sparks R.S. date 4/30/01 Existing System Inspection by: date

HEALTH DEPT. COPY: WHITE OWNER COPY (FINAL): YELLOW OWNER COPY (INITIAL): PINK