IREDELL COUNTY HEALTH DEPARTMENT

Paid 125.00 IP

STATESVILLE 704-878-5305 MOORESVILLE 704-664-5281

IMPROVEMENT PERMIT / AUTHORIZATION TO CONSTRUCT / OPERATION PERMIT / EXISTING SYSTEM INSPECTION

PERMIT# 090922 PIN# 4658995249 (pt) 4658 98 4884 DATE Dec 4, 00

OWNER OR CONTRACTOR Mid Carolina Dev. / Nathan Cerbelli PHONE: Business 634-0173 Home

ADDRESS P.O. Box 1580 Cornelius N.C. 28031

LOCATION 115 N. TK Shinnville Rd. TL Carolina Oaks TL Barnswallow on left at end 139 Barnswallow Ln

SUBDIVISION Grace Meadows BLOCK / SECTION LOT 25 LOT AREA 23,535 ft² SITE CLASS. PS DESIGN FLOW 360 gpd L.T.A.R. .3

Septic Tank: 1000 Gallons; STB 10 12 Date 8-18-01

Pump Tank: 1000 Gallons; PT 7 Date 10-8-00

Pump Make: Goulds Model WE05111H Serial No. L01400 38

Nitrification Field: No Fields 1 Square Feet 900 Linear Feet 300

No Lines 5@60' Trench Width 36" Max Trench Bottom Depth 36" Gravel Depth N/A

☑ New System ☐ Repair System Type: I, II, III, IV, V, VI

System Description: PM Innoflow-755 Rel

Repair System Description: PM - Panel Block

Maintenance Agreement Required: ☐ Yes ☑ No

☐ House/Mod. Home No. Bedrooms 3

☑ Mobile Home DW No. Bathrooms 2

☐ Business No. Employees

☐ Other

☐ Slab ☑ Crawl Space ☐ Basement w/plumbing ☐ Basement wo/plumbing


Water Supply: ☑ Individual ☐ Public ☐ Community

Comments:/Conditions: Install well exactly where shown. Maintain 100' between well & septic system area.

Comments:/Conditions: Checked lines & tanks. 12/24/01 mz
Polylok filter installed
Pressure tested 1/24/2002

1" = 50'

INITIAL SITE SKETCH

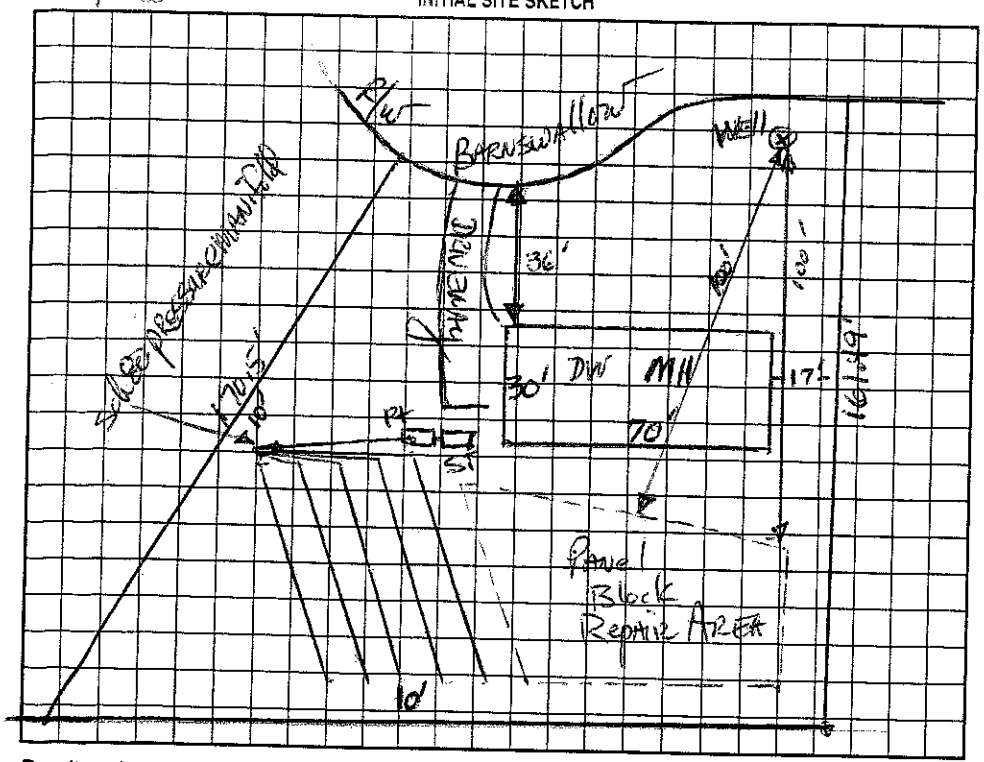

AS BUILT SKETCH

Installed 4 Plastic Chambers
as shown

Permit can be suspended or revoked if any false information is supplied toward securing the permit/any unauthorized changes are made to the site/any unauthorized changes are made in the installation of the system. Improvement Permit with plat valid without expiration. Improvement Permit with site plan valid for sixty months. Authorization to Construct is valid for a period equal to that of Improvement Permit – not to exceed sixty months.

Signed: date 12-5-00

Improvement Permit by: date 12-4-00

Authorization to Construct by: date 12/20/01

Installed by: Tommy Frye Grading

Operation Permit by: date 1/30/02

Existing System Inspection by: date

HEALTH DEPT. COPY: WHITE OWNER COPY (FINAL): YELLOW OWNER COPY (INITIAL): PINK