ICHD - ENVIRONMENTAL HEALTH DIVISION

Statesville Office (704) 878-5305 | Mooresville Office (704) 660-3625 | Repair

PERMIT # OSWP-2023-17408

SEPTIC: IMPROVEMENT PERMIT / AUTHORIZATION TO CONSTRUCT / OPERATION PERMIT / EXISTING SYSTEM

PIN # 4658-98-6794

APPLICANT / OWNER: Richard Amos | APPLICANT ADDRESS: 211 Shinnville Rd, Mooresville, NC 28115

SITE ADDRESS: 211 SHINNVILLE RD, MOORESVILLE, NC 28115 | PHONE: (704) 402-6766 | ALT. PHONE:


SITE DIRECTIONS: N NC21 -> R Shinnville -> lot on L | SAP CONTROLLED: YES ☐ NO ☐

SUBDIVISION: Jimmy Brawley Farm | SECTION: 2 | LOT #: 44 | LOT AREA: 0.69 | DESIGN FLOW: EX | L.T.A.R.: EXISTING


Septic Tank: 1000 (gal)	STB: 760	Date: 2-2-23	☐ New System ☒ Repair ☐ Expansion	System Type: II	☑ Residence	No. Bedrooms: EX	Water Supply: Existing Well
Pump Tank: (gal)	PT:	Date:	System Description: Existing Bed		☐ Business	No. Persons: EX	
Pump Make:	Model:	Serial #:	Repair System Description: New Tank		☐ Other	No. Employees:	
# Nitrification Fields: 1	# Lines: EXISTING	Linear Ft.: EXISTING	Maintenance Agreement Required: ☐ YES ☑ NO		☐ Slab	☑ Crawl Space	
Trench Width: EXISTING	Trench Bottom Depth (Low side): EXISTING		Gravel Depth: EXISTING	☑ GRAVITY ☐ PRESSURE	☐ Basement w/ Plumbing	☐ Basement w/o Plumbing	

Comments / Conditions: Pump, crush & fill existing tank. Replace distribution device device if necessary. May alter tank location if necessary as long as setbacks are met.

INITIAL SITE SKETCH

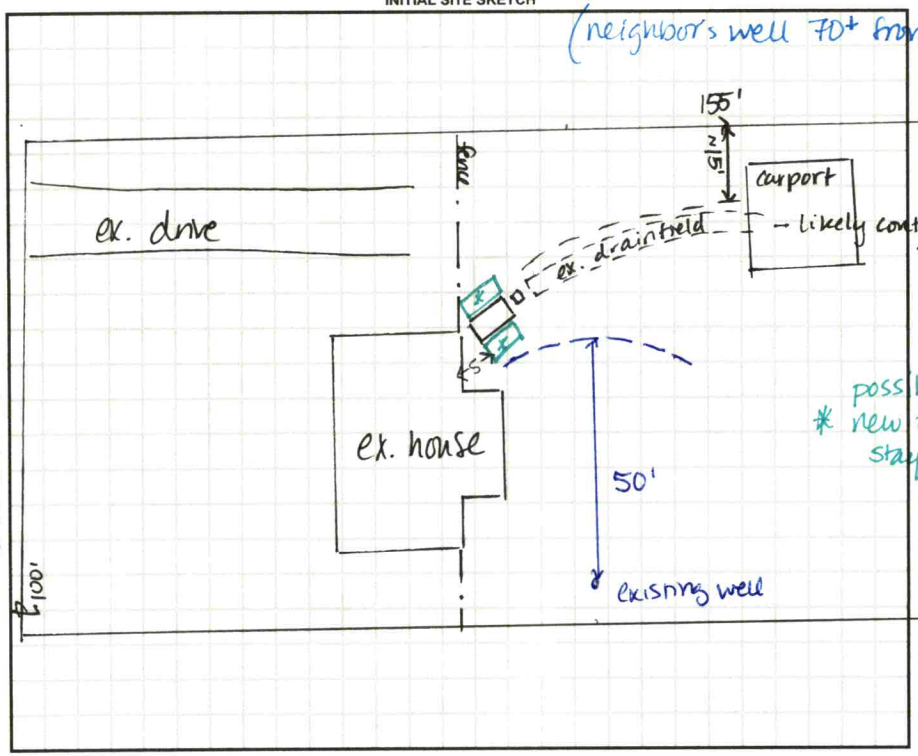

AS BUILT SKETCH

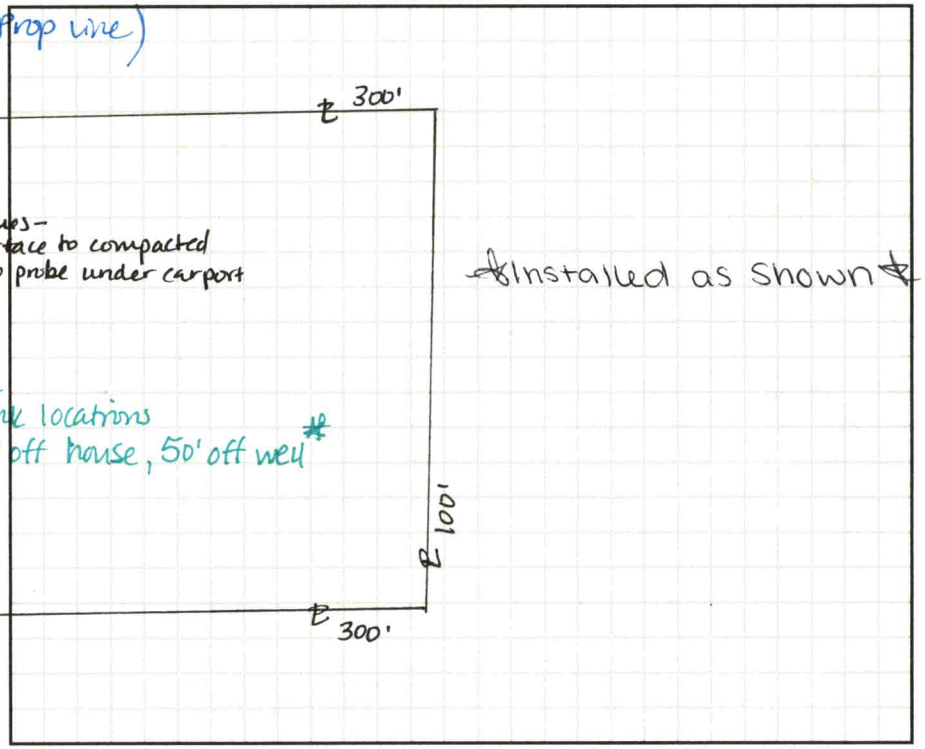

Permit can be suspended or revoked if any false information is supplied toward securing the permit / any unauthorized changes are made to the site / any unauthorized changes are made in the installation of the system. CONTACT A LOCATOR SERVICE PRIOR TO ANY EXCAVATION

☐ IMPROVEMENT PERMIT with plat valid without expiration. ☑ IMPROVEMENT PERMIT with site plan valid for 60 mos. ☑ AUTHORIZATION TO CONSTRUCT valid for period equal to IMPROVEMENT PERMIT--not to exceed 60 mo.

Owner / Applicant Signature: Richard Amos | Date:

IMPROVEMENT PERMIT by: D. Webber | Date: 3/7/23


AUTHORIZATION TO CONSTRUCT by: D. Webber | Date: 3/7/23

Installed By: Russell Williams

OPERATION PERMIT by: Sydney Hollaner | Date: 4/11/23

Existing System Inspected By: | Date:

FOR SEPTIC FINAL INSPECTION CALL: 704-664-3703 BETWEEN 8am-9am the day the inspection is needed.

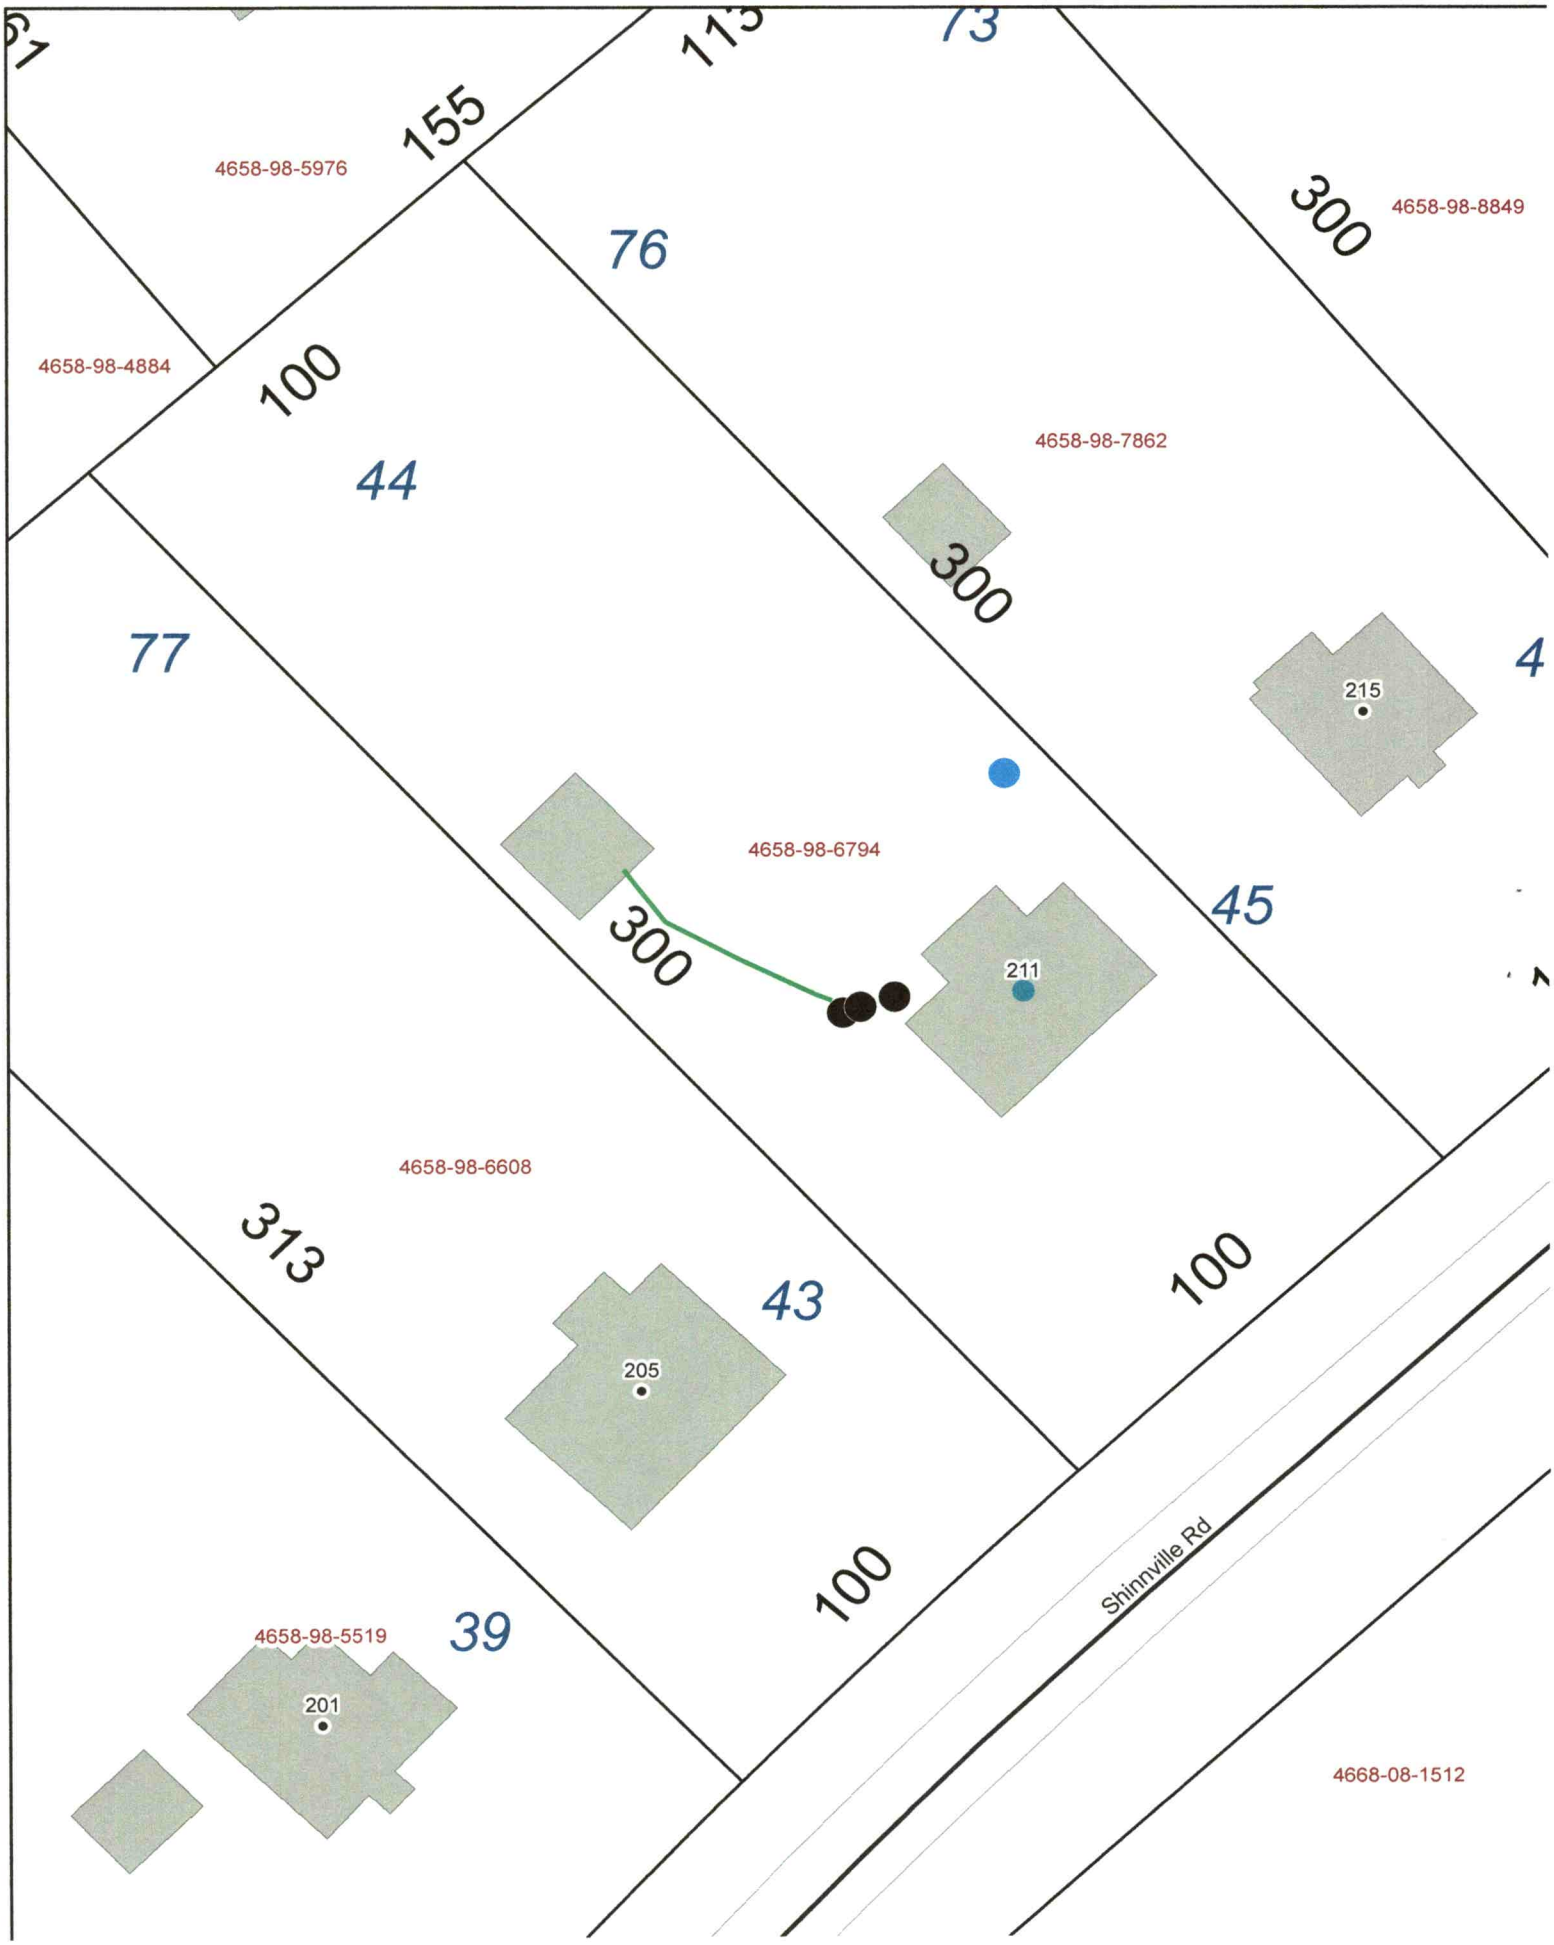
155
4658-98-5976
73
113
300
4658-98-8849
76
4658-98-4884
100
44
4658-98-7862
300
77
4
215
4658-98-6794
45
300
211
4658-98-6608
313
43
205
100
100
Shinnville Rd
4658-98-5519
39
201
4668-08-1512

PERMIT SNAPSHOT REPORT OSWP-2023-17408 FOR IREDELL COUNTY

Permit Type: Environmental Health OSWP
Work Class: EH Septic Improvement Permit Repair
Status: PRIORITY PERMIT
Valuation: $0.00
Project:
District: Iredell County
Square Feet: 0.00
Assigned To: Wieberg, Danielle
App Date: 02/25/2023
Exp Date: NOT AVAILABLE
Completed: NOT COMPLETED
Approval Expire Date:

Description: The septic tank has been inspected and has several issues. Root intrusion is the biggest issue and it has backed up into the house.

Parcel: 4658986794.000 Main
Address: 211 Shinnville Rd Main
Mooresville, NC 28115
Zone: RA(Residential Agricultural District)

Property Owner	Applicant/Authorized Agent	Applicant/Authorized Agent
Richard E Amos	Richard E Amos	Richard E Amos
211 Shinnville Rd	211 Shinnville Rd	211 Shinnville Rd
Mooresville, NC 28115	Mooresville, NC 28115	Mooresville, NC 28115
Mobile: (704) 402-6766	Mobile: (704) 402-6766	Mobile: (704) 402-6766

Permit Custom Fields

How is your site plan being submitted	Survey Plat	Does the site contain any jurisdictional wetlands	No	Non-domestic Sewage Generated	No
Other Public Agency	No	What are the proposed structures	Other Addition/Structure	Maximum Number of Bedrooms	3
Number of Occupants	2	Foundation Type	Crawl Space Foundation	Water Supply	Existing Well
Desired Septic System Type	Conventional (most common)	If other septic system type, please explain		If existing, Year existing system installed	1948
Additional Unique Setbacks Apply	No				

Attachment File Name	Added On	Added By	Attachment Group	Notes
Signature_Richard_Amos_2/25/2023.jpg	02/25/2023 11:46	Amos, Richard		Uploaded via CSS
Authorize to Act_v1.pdf	03/03/2023 15:13	Nebel, Barbara	Available Online	Authorize to Act as Agent
Septic Site Plan_v1.pdf	03/03/2023 15:13	Nebel, Barbara	Available Online	Site Plan

Invoice No.	Fee	Fee Amount	Amount Paid
NOT INVOICED	Existing System Septic Repair Permit	$150.00	$0.00
	Total for Invoice NOT INVOICED	**$150.00**	**$0.00**
	Grand Total for Permit	**$150.00**	**$0.00**

Workflow Step / Action Name	Action Type	Start Date	End Date
Application Completeness Check v.1		03/03/2023 15:13	03/03/2023 15:13
Confirm application complete v.1	Generic Action		03/03/2023 15:13
~~**Zoning Review v.1**~~			03/03/2023 15:13
~~Iredell County Zoning Approval v.1~~	Task		03/03/2023 15:13
~~Issue Invoice v.1~~	Generic Action		03/03/2023 15:13
~~Fees Paid v.1~~	Generic Action		03/03/2023 15:13
Assign v.1			
Case Assigned v.1	Generic Action		
Lot Readiness Verification v.1			
OSWP Septic Preliminary Site Visit v.1	Inspection		
OSWP Site Evaluation v.1	Inspection		
Permit Ready v.1			
Issue Permit v.1			
Issue Invoice v.1	Generic Action		

Fees Paid v.1	Generic Action
Issue Permit v.1	Generic Action
Environment Health Inspections v.1	
Operation Permit Inspection v.1	Inspection



Tax Map Information

• PIN	4658986794.000
• Address	211 SHINNVILLE RD
• Account #	Acct 80098153
• Tax Owner	AMOS VICTORIA
• Mailing Address	211 SHINNVILLE RD
•	MOORESVILLE, NC 28115
• GIS Owner	AMOS VICTORIA+RICHARD
• Deed Info	2964 / 551 - WD - 20221212
• Tax Acres	0.69 AC
• Lot #	44
• Description	JIMMY BRAWLEY FARM M2 PB4-15
• Zoning	RA
• Old Parcel #	0301Q01000A062
• Bldg Value	$74,920
• OBXF Value	$860
• Land Value	$29,060
• Total Value	$104,840
• Defer Value	$0
• Tax Districts	-ALLCNTY FIRE- -

IREDELL COUNTY NC


MAP FOR REFERENCE ONLY
NOT A LEGAL DOCUMENT

Iredell County, North Carolina makes no claims and no warranties, expressed or implied, concerning the validity or accuracy of the GIS data presented on this map.

Geometry updated 02/24/2023
Data updated 02/24/2023

Print map scale is approximate. Critical layout or measurement activities should not be done using this resource.

(from fence)
(A) 64 down
12 in
(B) 24
14

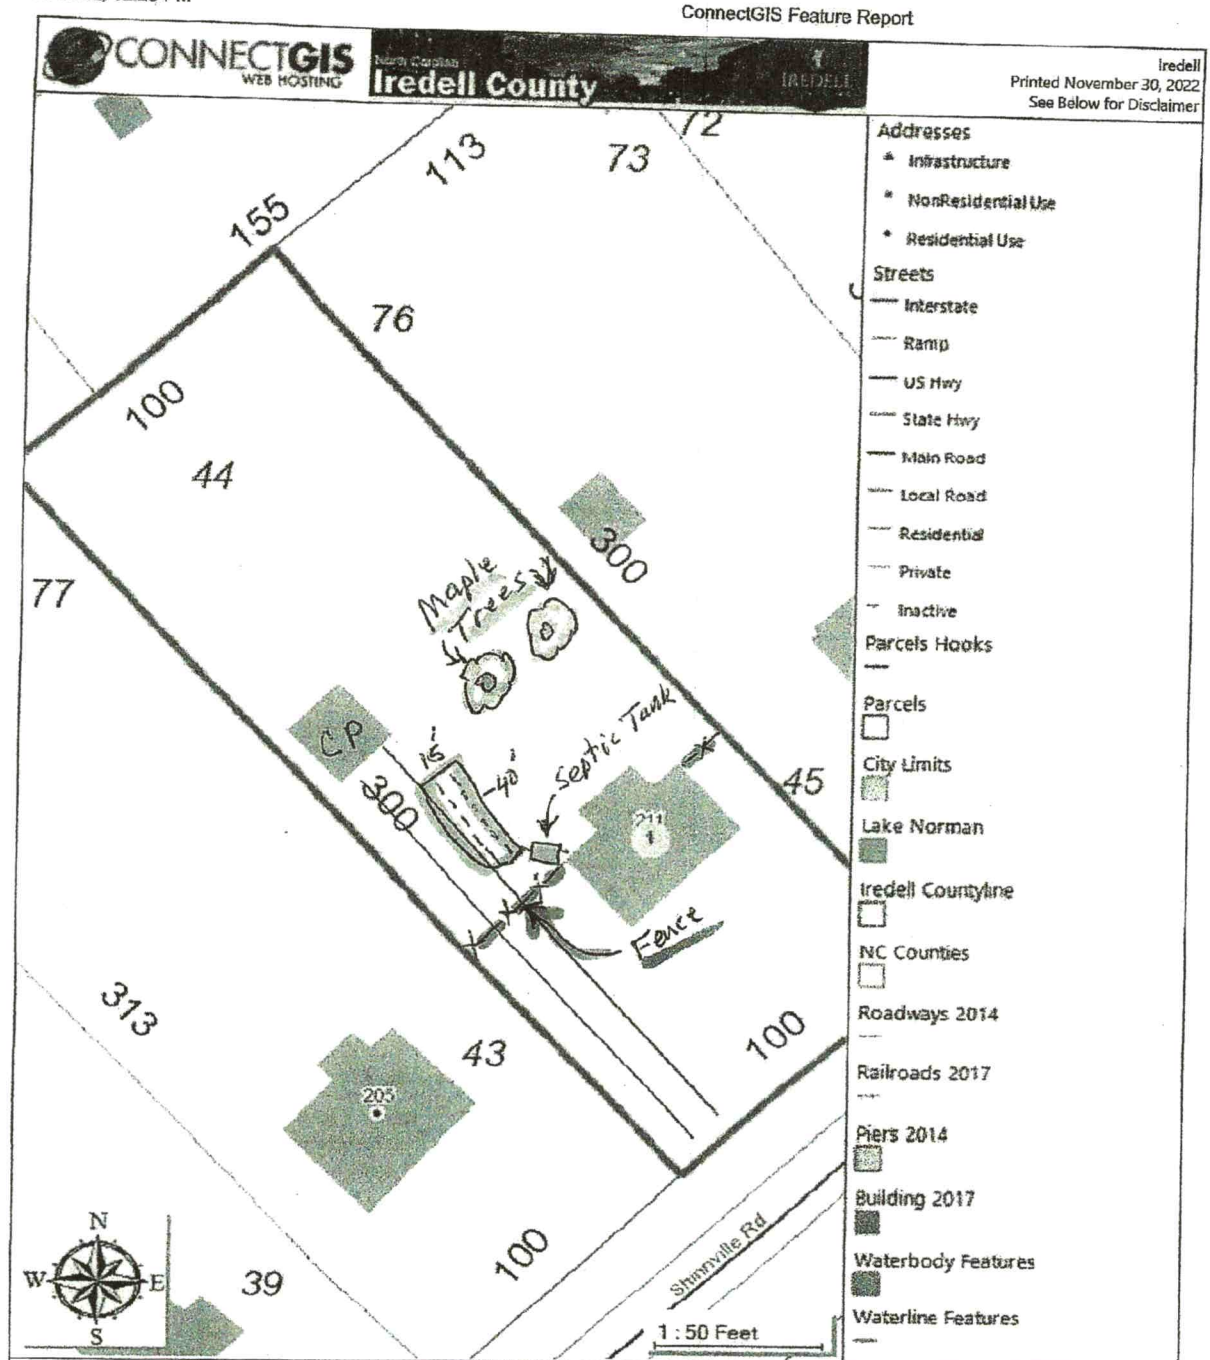

The maps prepared for this website are generated from recorded deeds, plats, and other public records. Users of these maps are hereby notified that the information provided herein should be verified. Iredell County assumes no legal responsibilities for any of the information contained on this site. Users are advised that the use of any of this information is at their own risk. All maps on this site were prepared using a 1000â€™ Grid based upon the North Carolina State Plane Coordinate System from the 1983 North American Datum. The delinquent real property tax overlay is updated monthly. The information presented is not intended to be used or relied upon as official notice of tax liens. For additional information regarding delinquent taxes, contact the Iredell County Tax Collector's Office.

Septic System Site Plan