4058987862

- (11:00) -

IREDELL COUNTY HEALTH DEPARTMENT

STATESVILLE 704-878-5305 MOORESVILLE 704-664-5281

IMPROVEMENT PERMIT / CERTIFICATE OF COMPLETION / OPERATION PERMIT / EXISTING SYSTEM INSPECTION

PROPERTY DESCRIPTION NO. Repair DATE 12/1/97 TAX MAP NO. Repair Watershed: ☐ Yes ☐ No

OWNER OR CONTRACTOR James Schronce PHONE: Business Repair Home 664-3329

ADDRESS 221 Shinnville Rd Mooresville, NC 28115

LOCATION 215 Shinnville Rd Hwy 21/115 TR, Shinnville Rd

SUBDIVISION BLOCK / SECTION LOT LOT AREA 100'x 300' SITE CLASS. PS DESIGN FLOW 240gpd L.T.A.R. .37

Septic Tank: 1000 Gallons; STB Date

Pump Tank: Gallons; PT Date

Pump Make: Model Serial No.

Nitrification Field: No Fields 1 Square Feet 750' Linear Feet 250'

No Lines 2 at 125' Trench Width 36" Max Trench Bottom Depth ~30" Gravel Depth 12"

☐ New System ☒ Repair System Type: I, II, III, IV, V, VI

System Description:

Repair System Description: Gravity - Conventional

Maintenance Agreement Required: ☐ Yes ☒ No

☒ House/Mod. Home No. Bedrooms 2

☐ Mobile Home No. Bathrooms 1

☐ Business No. Employees

☐ Other

☐ Slab ☒ Crawl Space ☐ Basement w/plumbing ☐ Basement wo/plumbing


Water Supply: ☐ Individual ☒ Community ☐ Public

Comments: Keep System at least 50' from any well & 5' from Building foundations. Keep Drainlines out of former Washing Machine pit area.


Comments:

INITIAL SITE SKETCH

Not to Scale.

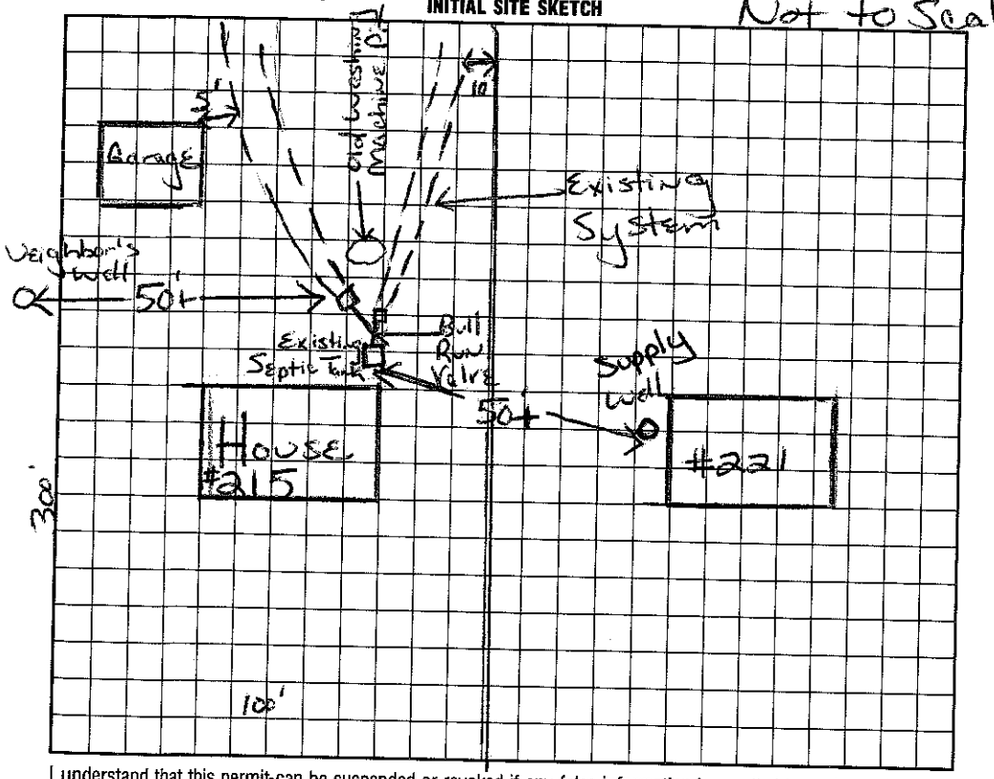

AS BUILT SKETCH

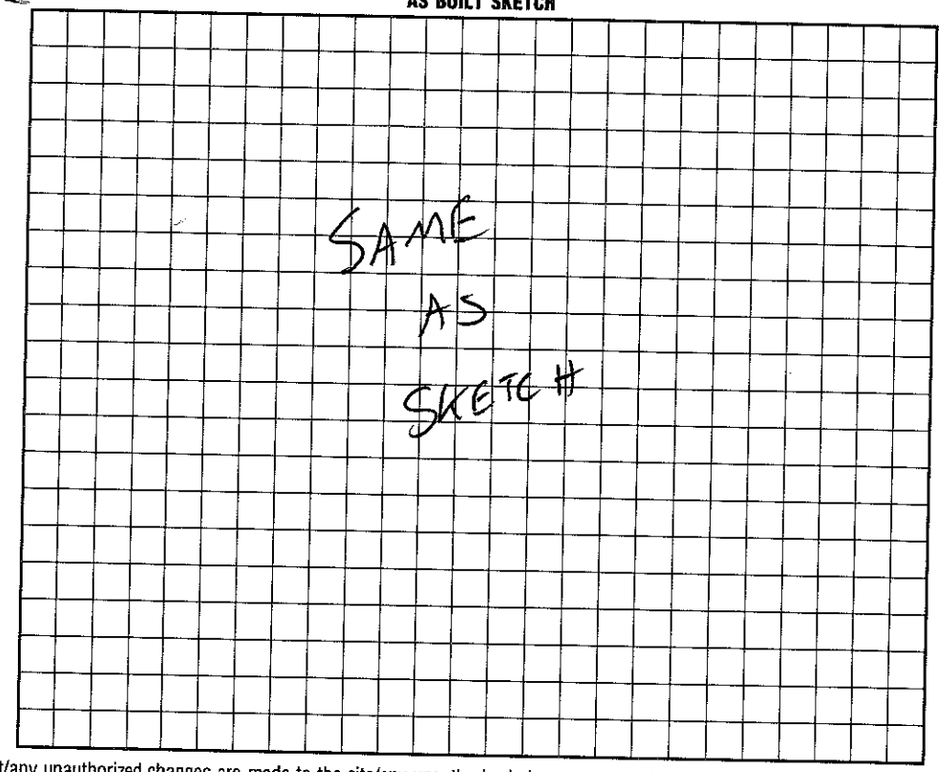

I understand that this permit can be suspended or revoked if any false information is supplied toward securing the permit/any unauthorized changes are made to the site/any unauthorized changes are made in the installation of the system. Improvement Permit is valid for 60 months from date of issuance.

Signed: LE Schronce

Improvement Permit by: Maria H. H. Dotson date 12/1/97

Existing System Inspection by: Maria H. H. Dotson date 12/1/97

Installed by: LARRY POWELL

Certificate of Completion by: date

Operation Permit by: date 12/10/97

HEALTH DEPT. COPY: WHITE INSPECTION COPY (FINAL): GREEN OWNER COPY (FINAL): YELLOW INSPECTION COPY (INITIAL): PINK OWNER COPY (INITIAL): GOLD

Auth to Construct