IREDELL COUNTY HEALTH DEPARTMENT

STATESVILLE 704-878-5305 MOORESVILLE 704-664-5281

IMPROVEMENT PERMIT / AUTHORIZATION TO CONSTRUCT / OPERATION PERMIT / EXISTING SYSTEM INSPECTION

125.00 Paid 2:30

PERMIT# 090858/109272 PIN# 4658995249 (pt.) 4658 99 1306 DATE Dec 15,00

OWNER OR CONTRACTOR Mid Carolina Dev./Fleetwood PHONE: Business 634-0173 Home

ADDRESS P.O. Box 1580 Cornelius N.C. 28031

LOCATION 115-21N TR Shinnville Rd. TL Carolina Wren TL Barnswallow TR Skylark Attend on Right

SUBDIVISION Grace Meadows BLOCK / SECTION LOT 17 LOT AREA .74ac SITE CLASS. PS DESIGN FLOW 360gpd L.T.A.R. .3±

Septic Tank: 1000 Gallons; STB 1012 Date 4/20/02

Pump Tank: 1000 Gallons; PT 17 Date 4/10/01

Pump Make: Myers Model 50 Serial No.

Nitrification Field: No Fields 1 Square Feet 960 Linear Feet 320

No Lines 4@80 Trench Width 36" Max Trench Bottom Depth 36" Gravel Depth NA

☑ New System ☐ Repair System Type: I II (III) IV V VI

System Description: PM - Innovative - 25% Red.

Repair System Description: LF Panel

Maintenance Agreement Required: ☐ Yes ☑ No initially

☐ House/Mod. Home No. Bedrooms 3

☑ Mobile Home DW No. Bathrooms 2

☐ Business No. Employees

☐ Other

☐ Slab ☑ Crawl Space ☐ Basement w/plumbing ☐ Basement wo/plumbing


Water Supply: ☑ Individual ☐ Public ☐ Community

Comments:/Conditions: Install well where shown & Maintain 100' Separation between well & Septic system
Tanks & lines Checked by GM 9/23/02


Comments:/Conditions: Building plans approved for 3 Bedroom & a Den per attached building plans 10/4/02 MP

1"=50'

INITIAL SITE SKETCH

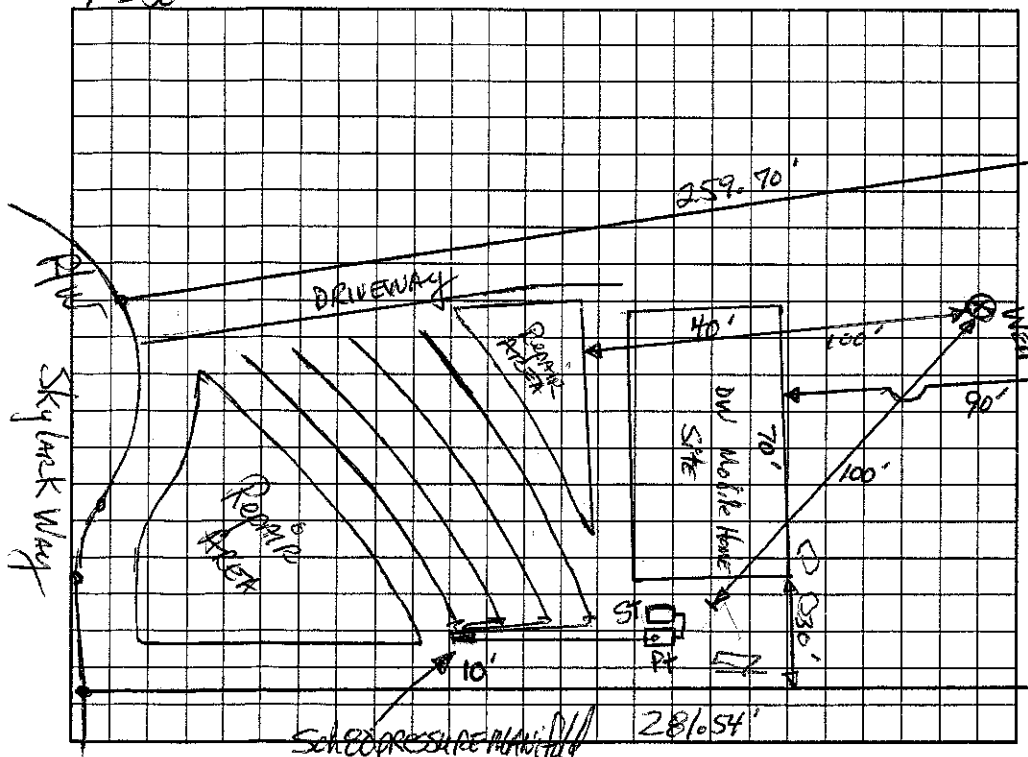

AS BUILT SKETCH

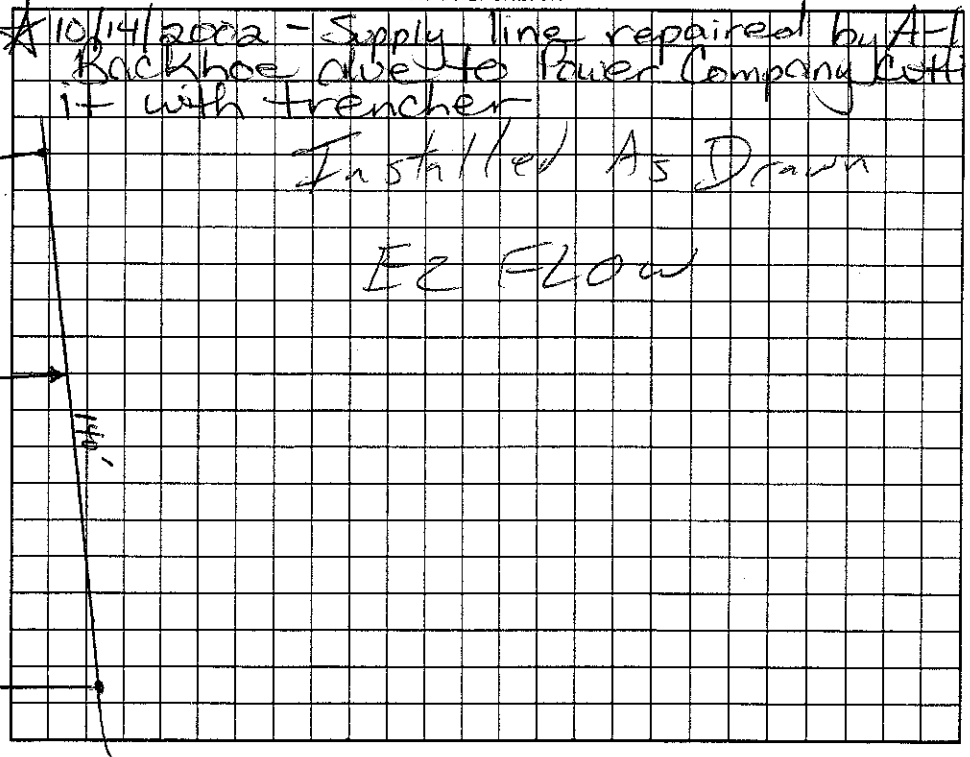

10/14/2002 - Supply line repaired by A-1 Backhoe due to Power Company cutting it with trencher

Installed As Drawn

EZ Flow

Permit can be suspended or revoked if any false information is supplied toward securing the permit/any unauthorized changes are made to the site/any unauthorized changes are made in the installation of the system. Improvement Permit with plat valid without expiration. Improvement Permit with site plan valid for sixty months. Authorization to Construct is valid for a period equal to that of Improvement Permit – not to exceed sixty months.

Signed: Steve K date 12-15-00 Installed by: A-1 Backhoe R.S.

Improvement Permit by: [signature] R.S. date 12-15-00 Operation Permit by: Marvin H. Dotson date 10/4/2002

Authorization to Construct by: [signature] date 9/24/02 Existing System Inspection by: date

HEALTH DEPT. COPY: WHITE OWNER COPY (FINAL): YELLOW OWNER COPY (INITIAL): PINK