10:30 JPM

IREDELL COUNTY HEALTH DEPARTMENT

STATESVILLE 704-878-5305 MOORESVILLE 704-664-5281

IMPROVEMENT PERMIT / AUTHORIZATION TO CONSTRUCT / OPERATION PERMIT / EXISTING SYSTEM INSPECTION

PERMIT # 158306 PIN # 4658992140 DATE 9-30-09 (Eric)

OWNER or APPLICANT Freedom Homes/Matthew Stikeleather HOME PHONE: Freedom 746-4778

OWNER or APPLICANT ADDRESS 1042 Charlotte Hwy Troutman, NC 28166

LOCATION / DIRECTIONS Hwy 21 N TR Shinnville Rd TL Carolina Wren TL Barnswallow TR Skylark Way ~~ahead~~ on left

SUBDIVISION Grace Meadows BLOCK / SECTION LOT # 20 LOT AREA .46Ac. DESIGN FLOW 360gpd L.T.A.R. .3

Septic Tank 1000 Gallons: STB 744 Date 11-21-09

Pump Tank Gallons: PT Date

Pump Make Model Serial #

Nitrification Field No Fields 1 No Lines 3 Linear Feet 300'

Trench Width 36" Max. Trench Bottom Depth 36" Gravel Depth N/A

☒ New System ☐ Repair ☐ Expansion System Type I II III IV V VI

System Description: Gravity - 25% Reduction

Repair System Description: Grav/Pump - 50% Reduction

Maintenance Agreement Required ☐ YES ☒ NO

☒ GRAVITY ☐ PRESSURE

☒ Residence No. Bedrooms 3

☐ Business No. Persons

☐ Other No. Employees

☐ Slab ☐ Crawl Space

☐ Basement w/plumbing ☐ Basement w/o plumbing


Water Supply ☒ Private well Easement ☐ Public ☐ Community

Comments / Conditions: Keep Septic System 100ft from well. Aug PL with driveway.

Scale 1:50

Comments / Conditions: Installed Plastic Chambers (4) essentially as Drawn >100ft to well on Easement

INITIAL SITE SKETCH

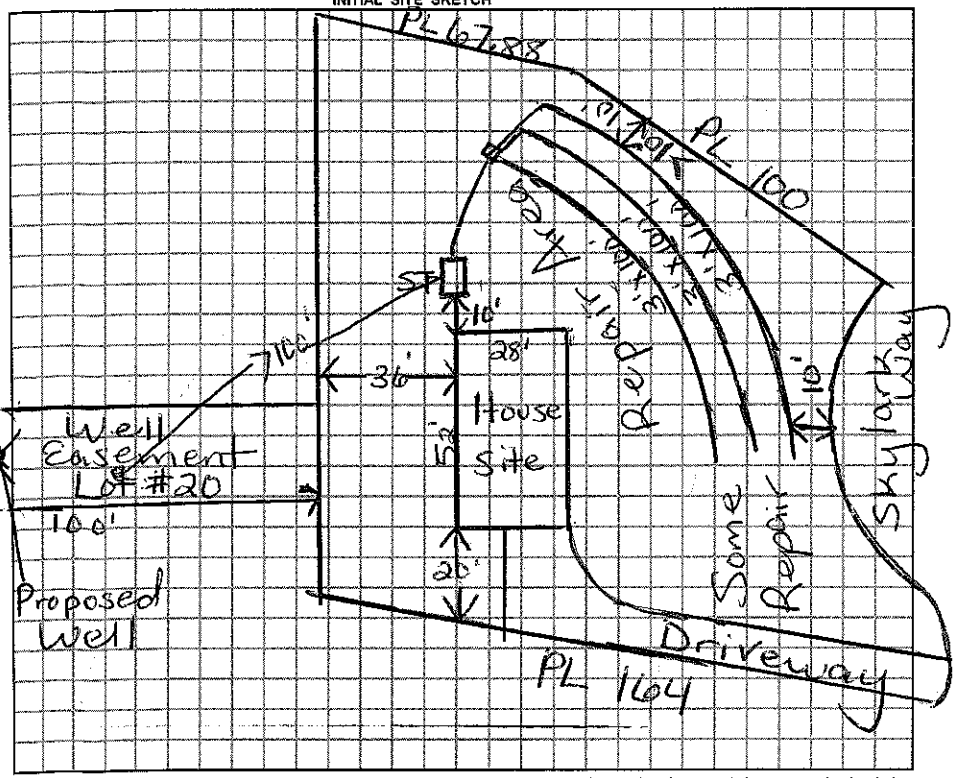

AS BUILT SKETCH

Permit can be suspended or revoked if any false information is supplied toward securing the permit / any unauthorized changes are made to the site / any unauthorized changes are made in the installation of the system.

☐ *IMPROVEMENT PERMIT w / plat valid without expiration.* ☐ *IMPROVEMENT PERMIT w / site plan valid for 60 mos.*

☒ *AUTHORIZATION TO CONSTRUCT valid for period equal to IMPROVEMENT PERMIT-not to exceed 60 mo.*

Owner / Applicant Signature: Eric W. Date 10-2-09

Improvement Permit by: Maria H. Cole, RS Date 9/30/09

Authorization to Construct by: Maria H. Cole, RS Date 9/30/09

Installed by: Gunter Grading

Operation Permit by: Maria H. Cole, RS Date: 4/11/2010

Existing System Inspected by: Date:

I SHOULD CONTACT A LOCATOR SERVICE PRIOR TO ANY EXCAVATION.

WHITE COPY Environmental Health YELLOW COPY (Final) Owner / Applicant PINK COPY (Initial) Owner / Applicant