IREDELL COUNTY HEALTH DEPARTMENT

STATESVILLE 704-878-5305 MOORESVILLE 704-664-5281

Pd 125.00 DT

IMPROVEMENT PERMIT / AUTHORIZATION TO CONSTRUCT / OPERATION PERMIT / EXISTING SYSTEM INSPECTION

PERMIT# 090918 PIN# ~~4658899524 9 (pt)~~ 4658-99-3156 DATE October 25, 00

OWNER OR CONTRACTOR Mid Carolina Nev. PHONE: Business 634-0173 Home

ADDRESS P.O. Box 1580 Cornelius N.C. 28031

LOCATION 115 N. TR Shinnville Rd. TL Carolina Wren TL Barnswallow TR Skylark on left

SUBDIVISION Grace Meadows BLOCK / SECTION LOT 21 LOT AREA 22,886 sf SITE CLASS PS DESIGN FLOW 360gpd L.T.A.R. .3

Septic Tank: 1000 Gallons; STB 3i2 Date 9/3/00

Pump Tank: Gallons; PT Date

Pump Make: Model Serial No.

Nitrification Field: No Fields 1 Square Feet 900 Linear Feet 300

No Lines 3 @ 100' Trench Width 36" Trench Bottom Depth 36" Gravel Depth NA

☑ New System ☐ Repair System Type: I, II, (III), IV, V, VI

System Description: Gravity Innovative 25%

Repair System Description: Same Rec

Maintenance Agreement Required: ☐ Yes ☑ No

☑ House/Mod. Home No. Bedrooms 3

☐ Mobile Home No. Bathrooms 3

☐ Business No. Employees

☐ Other

☐ Slab ☑ Crawl Space ☐ Basement w/plumbing ☐ Basement wo/plumbing


Water Supply: ☑ Individual ☐ Public ☐ Community

Comments:/Conditions: Well must be installed Exactly where shown in well easement

Comments:/Conditions: Maintain 100' Minimum between septic system & well so

Repair Area used

INITIAL SITE SKETCH 1"=50'

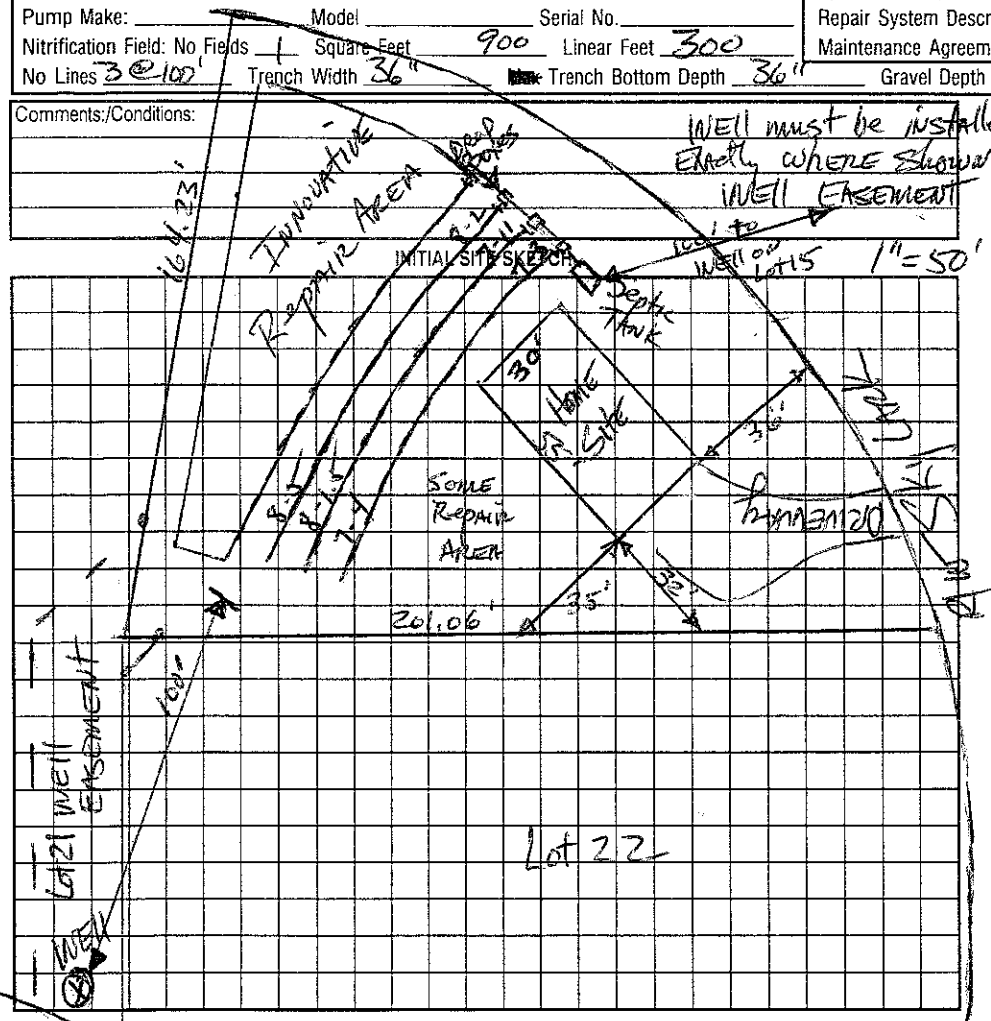

AS BUILT SKETCH

Permit can be suspended or revoked if any false information is supplied toward securing the permit/any unauthorized changes are made to the site/any unauthorized changes are made in the installation of the system. Improvement Permit with plat valid without expiration. Improvement Permit with site plan valid for sixty months. Authorization to Construct is valid for a period equal to that of Improvement Permit – not to exceed sixty months.

Signed: Steve Rg R/W Barnswallow Ln. date 10-25-00 Installed by: Marty Tucker

Improvement Permit by: date 10-25-00 Operation Permit by: Wesley Sparks RS date 12/5/00

Authorization to Construct by: date Existing System Inspection by: date

HEALTH DEPT. COPY: WHITE OWNER COPY (FINAL): YELLOW OWNER COPY (INITIAL): PINK