1:30-2:00

IREDELL COUNTY HEALTH DEPARTMENT

STATESVILLE 704-878-5305 MOORESVILLE 704-664-5281

IMPROVEMENT PERMIT / AUTHORIZATION TO CONSTRUCT / OPERATION PERMIT / EXISTING SYSTEM INSPECTION

PERMIT# 090856 PIN# ~~4658995249 (Lot)~~ 4658-99-3489 DATE Dec 15/00

OWNER OR CONTRACTOR Mid Carolina Dev. (TINA KRUEGER) PHONE: Business 634-0173 Home

ADDRESS P.O. Box 1580 Cornelius N.C. 28031

LOCATION I-15-21 N. TR Shinnville Rd. TL Carolina Wren TL Barnswallow TR Skylark on Right

SUBDIVISION Grace Meadows BLOCK / SECTION LOT 15 LOT AREA 1.28 Ac SITE CLASS. IS DESIGN FLOW 360gpd L.T.A.R. e3

Septic Tank: 1000 Gallons; STB 1612 Date 10-6-2000

Pump Tank: Gallons; PT Date

Pump Make: Model Serial No.

Nitrification Field: No Fields 1 Square Feet 1200 Linear Feet 400

No Lines 4 Trench Width 36" Max Trench Bottom Depth 36"

☑ New System ☐ Repair System Type: I, (II), III, IV, V, VI

System Description: Gravity Conventional

Repair System Description: Same

Maintenance Agreement Required: ☐ Yes ☑ No

Gravel Depth 12"

☐ House/Mod. Home No. Bedrooms 3

☑ ~~Mobile Home~~ OW No. Bathrooms 2

☐ Business No. Employees

☐ Other

☐ Slab ☑ Crawl Space ☐ Basement w/plumbing ☐ Basement wo/plumbing


Water Supply: ☑ ~~Individual~~ ☐ Public ☐ Community

Comments:/Conditions: INSTALL WELL EXACTLY where shown. Maintain 100' Separation between wells & Septic Systems.


Comments:/Conditions: Verified well distance, 100' exactly

1"=50'

INITIAL SITE SKETCH

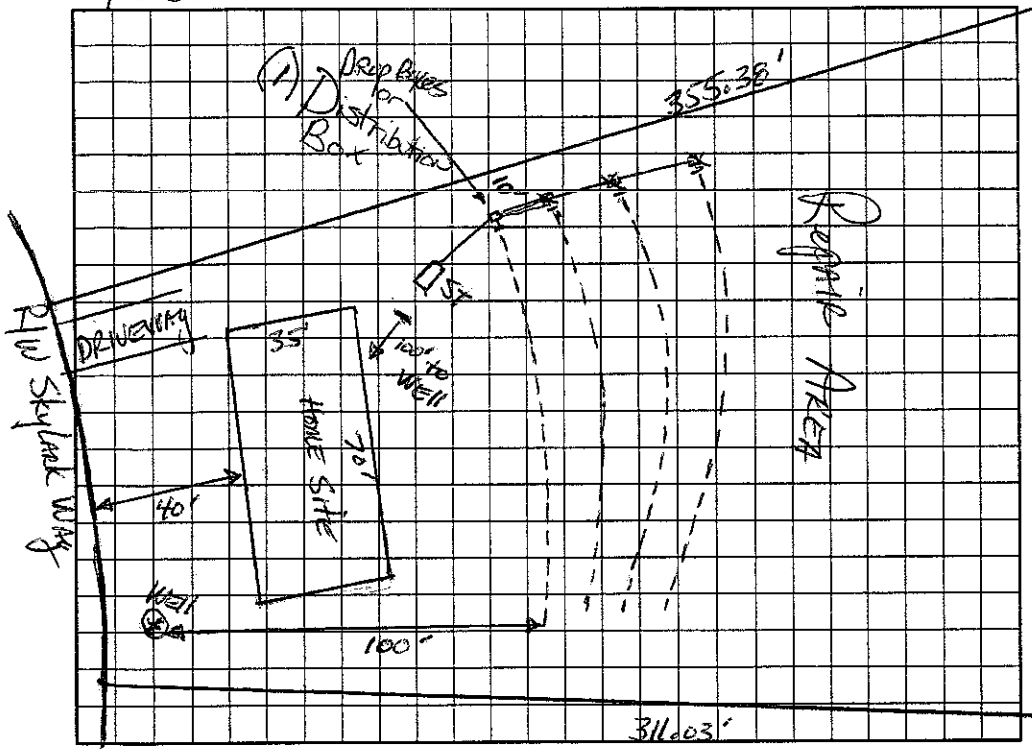

AS BUILT SKETCH

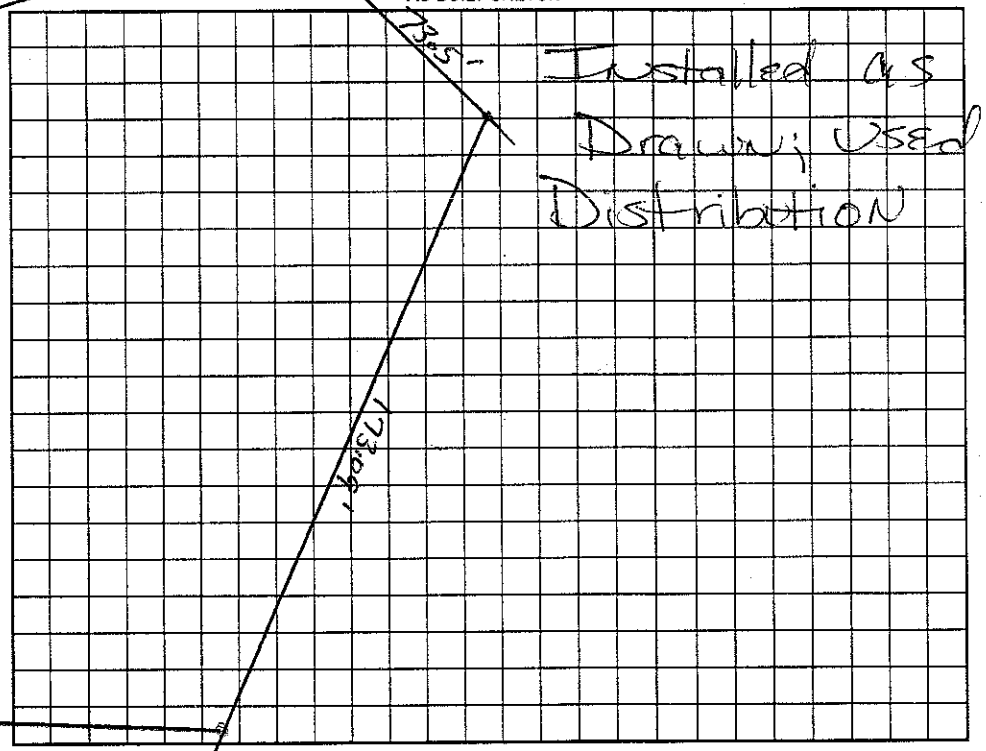

Permit can be suspended or revoked if any false information is supplied toward securing the permit/any unauthorized changes are made to the site/any unauthorized changes are made in the installation of the system. Improvement Permit with plat valid without expiration. Improvement Permit with site plan valid for sixty months. Authorization to Construct is valid for a period equal to that of Improvement Permit – not to exceed sixty months.

Signed: Steve Ry date 12-15-00 Installed by: Richard Abernathy

Improvement Permit by: Mark R. Morgan, RS date 12-15-00 Operation Permit by: Mark H. Dotson RS date 4/26/2001

Authorization to Construct by: Wesley Sparks R.S. date 2/14/01 Existing System Inspection by: date

HEALTH DEPT. COPY: WHITE OWNER COPY (FINAL): YELLOW OWNER COPY (INITIAL): PINK