IREDELL COUNTY HEALTH DEPARTMENT

STATESVILLE 704-878-5305 Paid 175.00 DT MOORESVILLE 704-664-5281 9:30

IMPROVEMENT PERMIT / AUTHORIZATION TO CONSTRUCT / OPERATION PERMIT / EXISTING SYSTEM INSPECTION

PERMIT# 090919 PIN# ~~4658995249 (lot)~~ 4658-99-4140 DATE October 25, 00

OWNER OR CONTRACTOR Mid Carolina Dev II Fleetwood Homes - Albert Jackson PHONE: Business 634-0173 Home

ADDRESS PO Box 1580 Cornelius NC 28031

LOCATION 115 No. TR Shinnville Rd. TL Carolina Aiken TL Barnswallow on right at jct. w/ Skylark

SUBDIVISION Grace Meadows BLOCK / SECTION LOT 22 LOT AREA 25,606 ft² SITE CLASS. PS DESIGN FLOW 360 gpd L.T.A.R. .03±

Septic Tank: 1000 Gallons: STB 794 Date 5-13-01
Pump Tank: Gallons; PT Date
Pump Make: Model Serial No.
Nitrification Field: No Fields 1 Square Feet 960 Linear Feet 320
No Lines 4@80' Trench Width 36" Trench Bottom Depth 36" Gravel Depth NA

☑ New System ☐ Repair System Type: I, II, III, IV, V, VI
System Description: Gravity Innovative - 25% Red.
Repair System Description: LP Panel Block
Maintenance Agreement Required: ☐ Yes ☑ No/Initially

☑ House/Mod. Home No. Bedrooms 3
☐ Mobile Home No. Bathrooms 3
☐ Business No. Employees
☐ Other
☐ Slab ☑ Crawl Space ☐ Basement w/plumbing ☐ Basement wo/plumbing

Water Supply: ☑ Individual ☐ Public ☐ Community


Comments:/Conditions: Install well exactly where shown. Maintain 100' minimum between septic system and well so

5-23-01, Reviewed floor plan; in compliance w/ I.P. DBH

Comments:/Conditions: Grey filter installed.

1" = 50

INITIAL SITE SKETCH

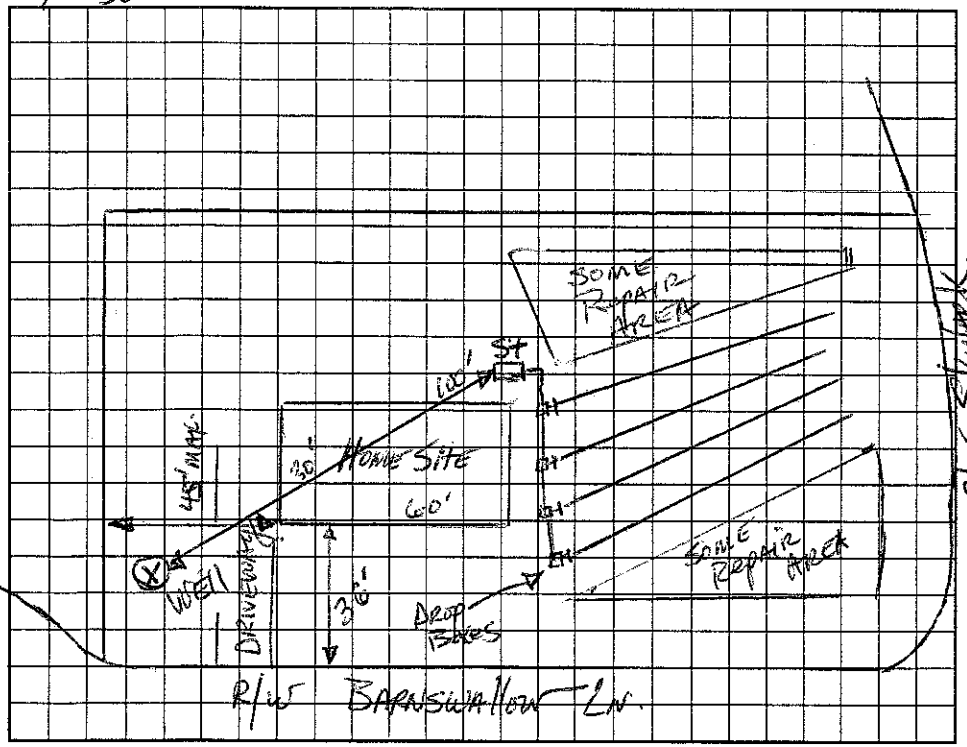

AS BUILT SKETCH

Installed as Drawn

Permit can be suspended or revoked if any false information is supplied toward securing the permit/any unauthorized changes are made to the site/any unauthorized changes are made in the installation of the system. Improvement Permit with plat valid without expiration. Improvement Permit with site plan valid for sixty months. Authorization to Construct is valid for a period equal to that of Improvement Permit – not to exceed sixty months.

Signed: Steve Rg date 10-25-00
Improvement Permit by: David Harmon, RS date 10-25-00
Authorization to Construct by: David Harmon, RS date 5-22-01

Installed by: Craig Thompson
Operation Permit by: Maine H. Nelson RS. date 6/15/2001
Existing System Inspection by: date

HEALTH DEPT. COPY: WHITE OWNER COPY (FINAL): YELLOW OWNER COPY (INITIAL): PINK