11-07

IREDELL COUNTY HEALTH DEPARTMENT

STATESVILLE 704-878-5305 MOORESVILLE 704-664-5281

IMPROVEMENT PERMIT / AUTHORIZATION TO CONSTRUCT / OPERATION PERMIT / EXISTING SYSTEM INSPECTION

PERMIT# 090853 PIN# ~~4650715249 (pt)~~ 4658-99-6600 DATE Nov. 18, 00

OWNER OR CONTRACTOR Mid Carolina Dev. / FLEETWOOD Homes PHONE: Business 634-0193 Home

ADDRESS P.O. Box 1580 Cornelius N.C. 28031

LOCATION 115 N. TR Statesville TL Carolina Wren ● At end on left

SUBDIVISION Grace Meadows BLOCK / SECTION LOT 9 LOT AREA 34,289 ft² SITE CLASS. PS DESIGN FLOW 360 gpd L.T.A.R. .03

Septic Tank: 1000 Gallons; STB 1012 Date 11/10/01

Pump Tank: Gallons; PT Date

Pump Make: Model Serial No.

Nitrification Field: No Fields 1 Square Feet 900 Linear Feet 300

No Lines 3 @ 100' Trench Width 36" Max Trench Bottom Depth 36"

☑ New System ☐ Repair System Type: I, II, III, IV, V, VI

System Description: Conv. Innovative - 250 gal.

Repair System Description: 1 Same

Maintenance Agreement Required: ☐ Yes ☑ No

Gravel Depth NA

☑ House/Mod. Home No. Bedrooms 3

☐ Mobile Home No. Bathrooms 3

☐ Business No. Employees

☐ Other

☐ Slab ☑ Crawl Space ☐ Basement w/plumbing ☐ Basement wo/plumbing


Water Supply: ☑ Individual ☐ Public ☐ Community

Comments:/Conditions: Install well exactly where shown. Maintain 100' Minimum Separation between well & septic system


Comments:/Conditions:

1" = 50'

INITIAL SITE SKETCH

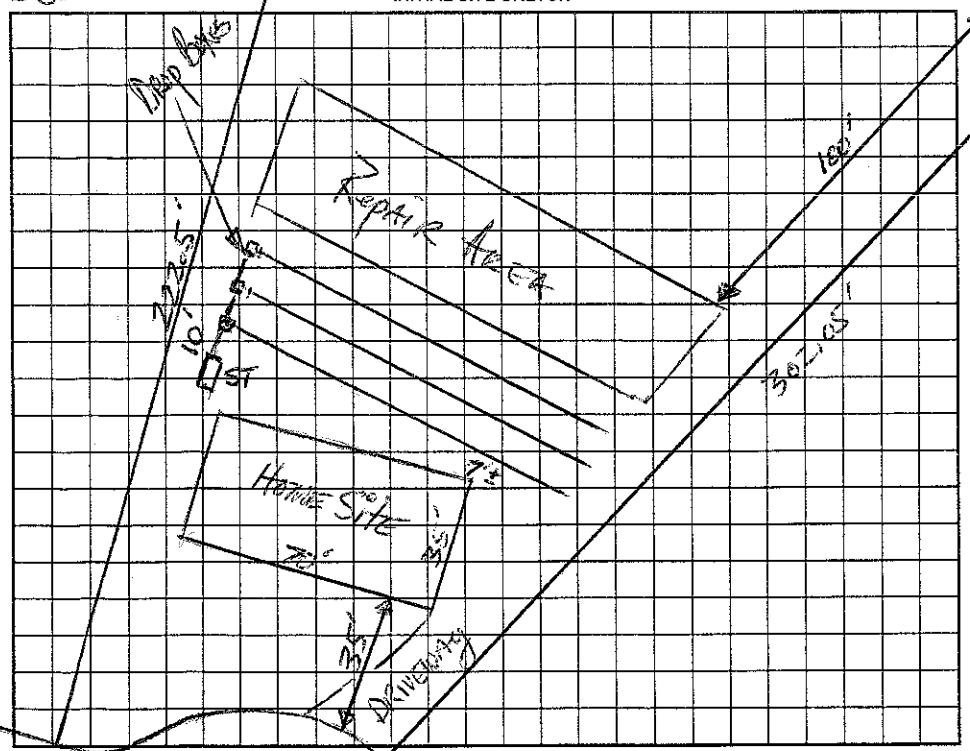

AS BUILT SKETCH

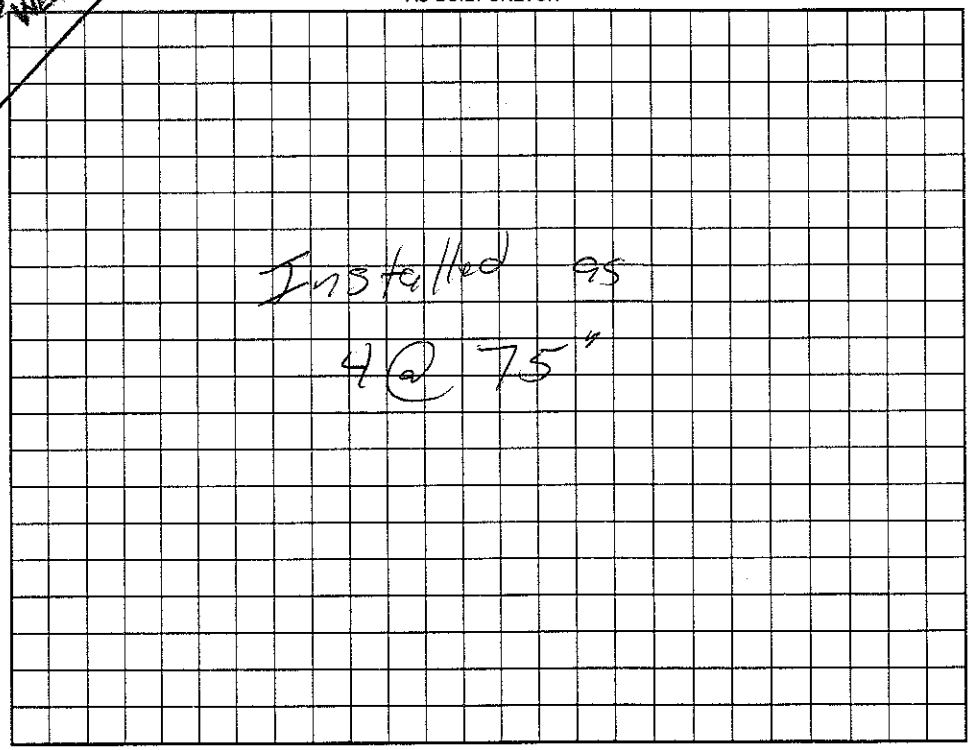

Permit can be suspended or revoked if any false information is supplied toward securing the permit/any unauthorized changes are made to the site/any unauthorized changes are made in the installation of the system. Improvement Permit with plat valid without expiration. Improvement Permit with site plan valid for sixty months. Authorization to Construct is valid for a period equal to that of Improvement Permit – not to exceed sixty months.

Signed: date 11-27-00 Installed by: A-1 Backhoe

Improvement Permit by: date 11-18-00 Operation Permit by: date 4/3/02

Authorization to Construct by: C. date 4/2/02 Existing System Inspection by: date

HEALTH DEPT. COPY: WHITE OWNER COPY (FINAL): YELLOW OWNER COPY (INITIAL): PINK