4658999063

IREDELL COUNTY HEALTH DEPARTMENT

STATESVILLE 704-878-5305 MOORESVILLE 704-664-5281

IMPROVEMENT PERMIT / ~~CERTIFICATE OF COMPLETION~~ / OPERATION PERMIT / EXISTING SYSTEM INSPECTION

PROPERTY DESCRIPTION NO. 22038 DATE 10/2/95 TAX MAP NO. 1Q-1-A-57 Pt of Watershed: [X] Yes [ ] No

OWNER OR CONTRACTOR Barry M. Winecoff PHONE: Business Home 549-1072

ADDRESS 3216 G High Glen Dr. Charlotte, NC. 28269

LOCATION Shinnville Rd, on (R) of 225 Shinnville Rd.

SUBDIVISION Walter E Sherrill BLOCK / SECTION LOT 57 LOT AREA ~ 30,000 SITE CLASS. PS DESIGN FLOW 360 L.T.A.R. .36

Septic Tank: 1000 Gallons; STB 794 Date 3500 psi

Pump Tank: Gallons; PT Date

Pump Make: Model Serial No.

Nitrification Field: No Fields 1 Square Feet 1200 Linear Feet 400

No Lines 5 Trench Width 36" Max Trench Bottom Depth 33" Gravel Depth 12"

[X] New System [ ] Repair System Type: I (II) III, IV, V, VI

System Description: Density Conventional

Repair System Description:

Maintenance Agreement Required: [ ] Yes [X] No

[X] House/Mod. Home No. Bedrooms 3

[ ] Mobile Home No. Bathrooms 2

[ ] Business No. Employees

[ ] Other


[ ] Slab [X] Crawl Space [ ] Basement w/plumbing [ ] Basement wo/plumbing

Water Supply: [X] Individual [ ] Community [ ] Public


Comments:

Comments:

INITIAL SITE SKETCH

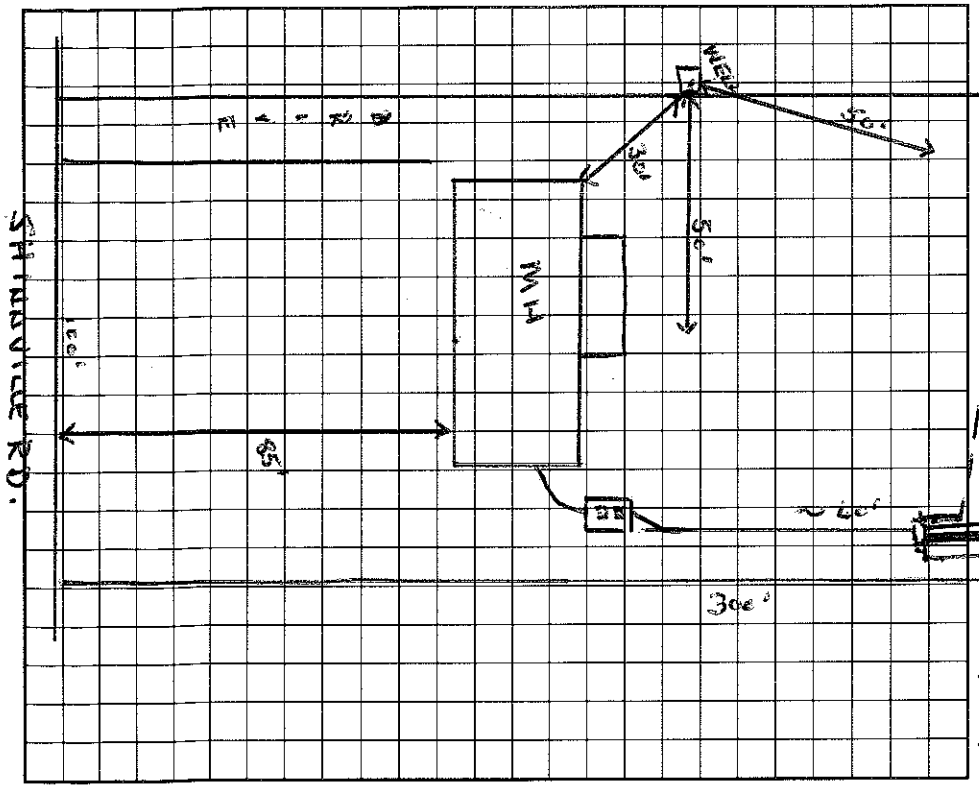

AS BUILT SKETCH

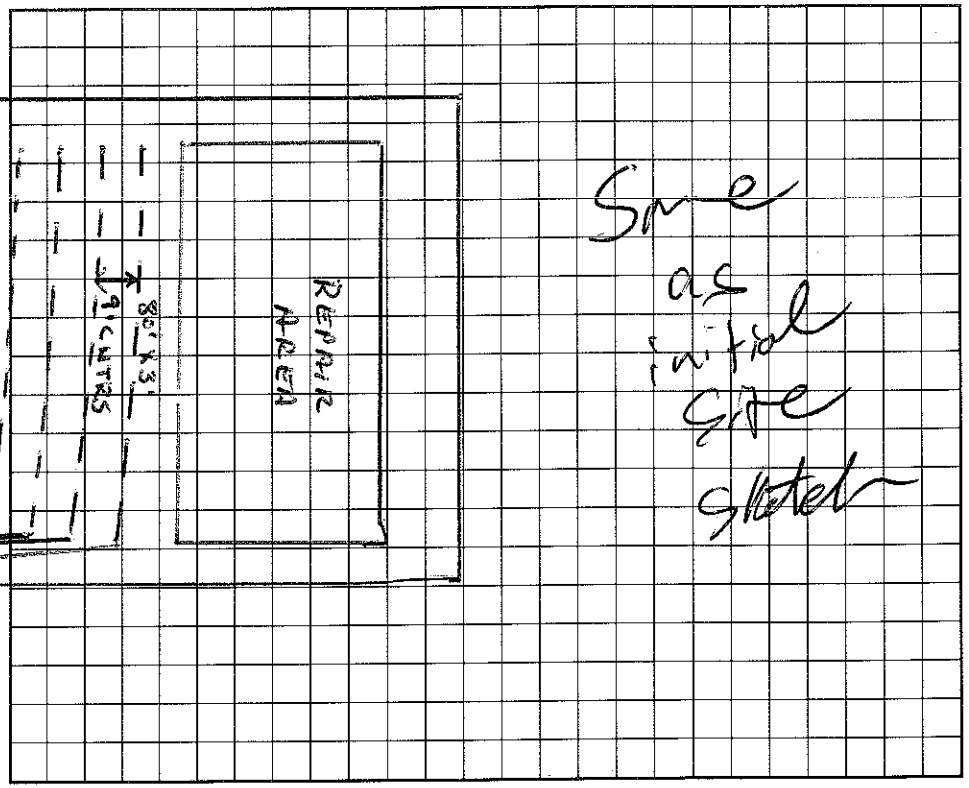

Same as initial site sketch

I understand that this permit can be suspended or revoked if any false information is supplied toward securing the permit/any unauthorized changes are made to the site/any unauthorized changes are made in the installation of the system.

AUTHORIZATION VALID 5 YEARS FROM ISSUE DATE

Signed: Barry M. Winecoff

Improvement Permit by: Wesley Sparks R.S. date 10/2/95

~~Authorization to Construct~~ ~~Existing System Inspection~~ by: Wesley Sparks R.S. date 10/2/95

Installed by: Larry Beam

~~Certificate of Completion~~ ~~Existing System~~ by: date

Operation Permit by: EHSF date 9/3/96

HEALTH DEPT. COPY: WHITE INSPECTION COPY (FINAL): GREEN OWNER COPY (FINAL): YELLOW INSPECTION COPY (INITIAL): PINK OWNER COPY (INITIAL): GOLD