IREDELL COUNTY HEALTH DEPARTMENT

STATESVILLE 704-878-5305 130.00 Paid MOORESVILLE 704-664-5281

IMPROVEMENT PERMIT / AUTHORIZATION TO CONSTRUCT / OPERATION PERMIT / EXISTING SYSTEM INSPECTION

PERMIT# 124037 PIN# 4659 03 9461 DATE 10/21/04

OWNER OR CONTRACTOR Joanne Patterson PHONE: Business 704-528-4874 Home

ADDRESS PO Box 1467 Mooresville, NC 28115

LOCATION 115 N TL Parkertown Rd. TL Duncan Ln., 1st Lot on R

SUBDIVISION No BLOCK / SECTION LOT LOT AREA SITE CLASS. RS DESIGN FLOW 240 L.T.A.R. .3

Septic Tank: ~1000 Gallons; STB 350 Date 9/14/04

Pump Tank: Gallons; PT Date

Pump Make: Model Serial No.

Nitrification Field: No Fields 1 Square Feet 600 Linear Feet 200

No Lines 2 @ 100 Trench Width 3' Max Trench Bottom Depth 3' Gravel Depth No

☒ New System ☐ Repair System Type: I, II, III, IV, V, VI

System Description: GRAVITY - Type 3

Repair System Description: SAME

Maintenance Agreement Required: ☐ Yes ☒ No

☐ House/Mod. Home No. Bedrooms 2

☒ Mobile Home No. Bathrooms 1

☐ Business No. Employees

☐ Other

☐ Slab ☒ Crawl Space ☐ Basement w/plumbing ☐ Basement wo/plumbing


Water Supply: ☒ Individual ☐ Public ☐ Community

Comments:/Conditions: This is a 25% reduced system.

Comments:/Conditions:

1" = 40'

INITIAL SITE SKETCH

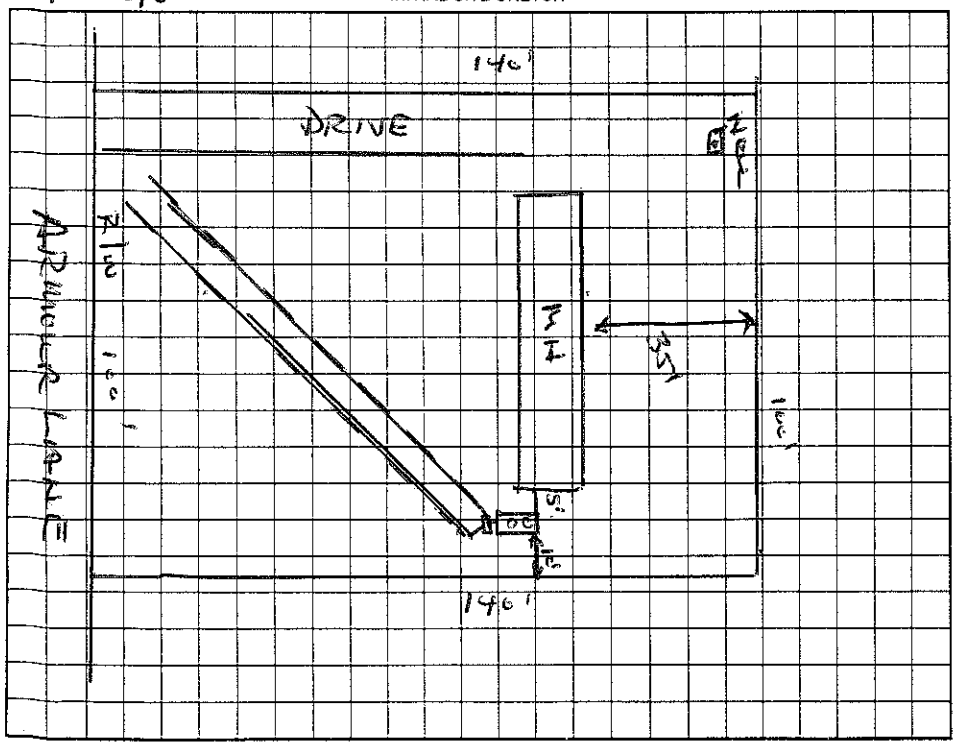

AS BUILT SKETCH

Permit can be suspended or revoked if any false information is supplied toward securing the permit/any unauthorized changes are made to the site/any unauthorized changes are made in the installation of the system. Improvement Permit with plat valid without expiration. Improvement Permit with site plan valid for sixty months. Authorization to Construct is valid for a period equal to that of Improvement Permit – not to exceed sixty months.

Signed: Joanne Patterson date 10/28/04

Improvement Permit by: Wesley Sparks RS. date 10/21/04

Authorization to Construct by: Wesley Sparks RS date 10/21/04

Installed by: Piedmont Septic Tank

Operation Permit by: Wesley Sparks RS date 12/17/04

Existing System Inspection by: date

HEALTH DEPT. COPY: WHITE OWNER COPY (FINAL): YELLOW OWNER COPY (INITIAL): PINK