# IREDELL COUNTY HEALTH DEPARTMENT

STATESVILLE 704-878-5305 MOORESVILLE 704-664-5281

## IMPROVEMENT PERMIT / AUTHORIZATION TO CONSTRUCT / OPERATION PERMIT / EXISTING SYSTEM INSPECTION

PERMIT# 083586 PIN# 4659 03 9795 DATE 9/30/99

OWNER OR CONTRACTOR Johnny Ray Reid PHONE: Business Home 662-9212

ADDRESS 583 W McClelland Ave. Mooresville, NC. 28115

LOCATION 115N TL Parkertown Rd. TL Armour at end on (L)

SUBDIVISION No BLOCK / SECTION LOT LOT AREA ~.92 SITE CLASS. PS DESIGN FLOW 480 L.T.A.R. .3

Septic Tank: 1000 Gallons; STB 825 Date 11/1/99
Pump Tank: Gallons; PT Date
Pump Make: Model Serial No.
Nitrification Field: No Fields 1 Square Feet 1200 Linear Feet *400
No Lines 64 Trench Width 36" Max Trench Bottom Depth 36" Gravel Depth SAND

☒ New System ☐ Repair System Type: I, II (III) IV, V, VI
System Description: GRAVITY - CH PLASTIC
Repair System Description: 16" PPBS
Maintenance Agreement Required: ☐ Yes ☒ No


☒ House/Mod. Home No. Bedrooms 4
☐ Mobile Home No. Bathrooms 4
☐ Business No. Employees
☐ Other
☐ Slab ☒ Crawl Space ☐ Basement w/plumbing ☐ Basement wo/plumbing

Water Supply: ☒ Individual ☐ Public ☐ Community


Comments:/Conditions:

Comments:/Conditions:

INITIAL SITE SKETCH

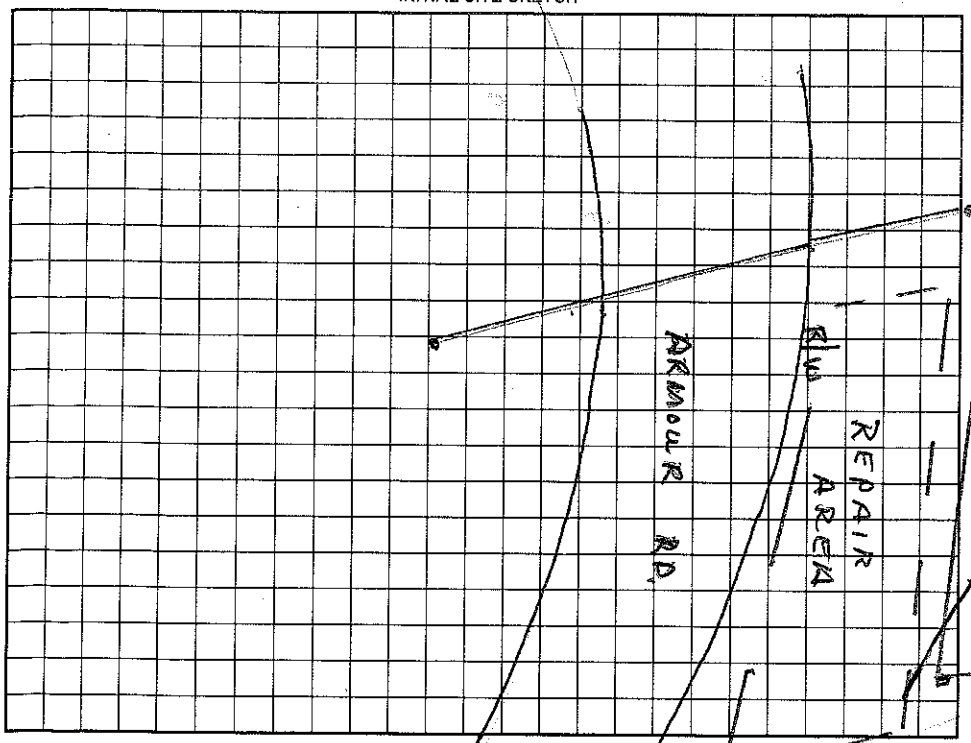


AS BUILT SKETCH

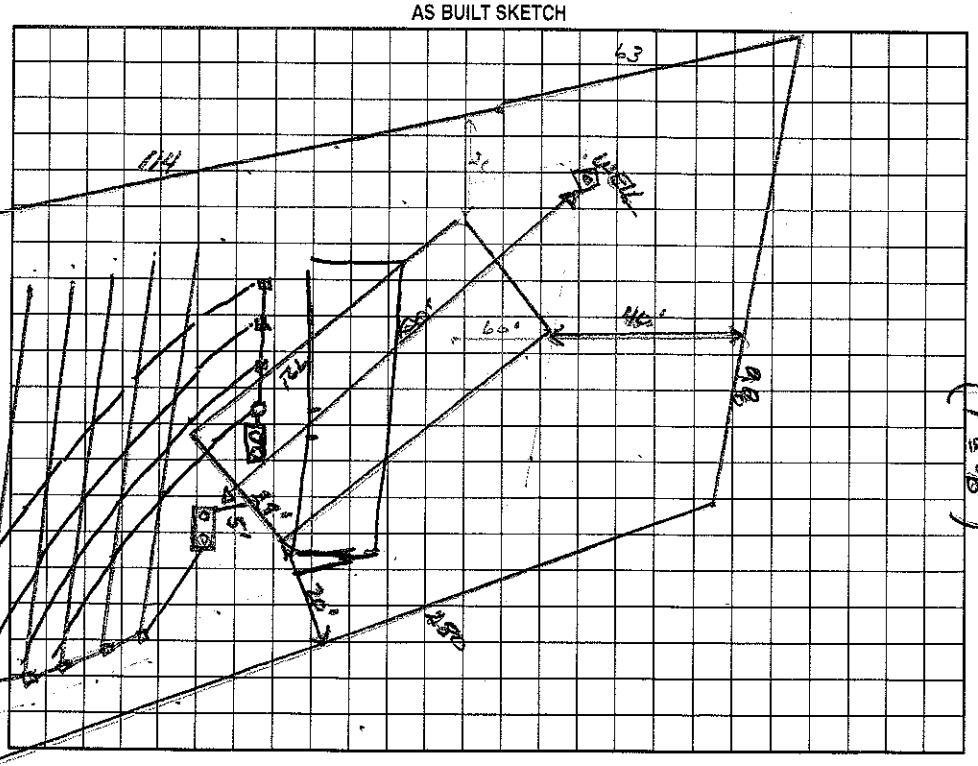


Permit can be suspended or revoked if any false information is supplied toward securing the permit/any unauthorized changes are made to the site/any unauthorized changes are made in the installation of the system. Improvement Permit with plat valid without expiration. Improvement Permit with site plan valid for sixty months. Authorization to Construct is valid for a period equal to that of Improvement Permit – not to exceed sixty months.

Signed Johnny Reid date 10/1/99

Improvement Permit by: Wesley Sparks RS. date 9/30/99

Authorization to Construct by: Wesley Sparks RS date 9/30/99

Installed by: C+W Grading

Operation Permit by: Wesley Sparks RS. date 1/6/2000

Existing System Inspection by: date

HEALTH DEPT. COPY: WHITE OWNER COPY (FINAL): YELLOW OWNER COPY (INITIAL): PINK