IREDELL COUNTY HEALTH DEPARTMENT

STATESVILLE 704-878-5305 | MOORESVILLE 704-664-5281

IMPROVEMENT PERMIT / AUTHORIZATION TO CONSTRUCT / OPERATION PERMIT / EXISTING SYSTEM INSPECTION

125.00 Paid

PERMIT# 093343 PIN# ~~4649-95-0453~~ 4659050453 DATE 2/7/01

OWNER OR CONTRACTOR Pruitt Dev. Co, LLC PHONE: Business (704) 660-5903 Home —

ADDRESS 142 Stutts Rd Mooresville NC 28117

LOCATION I-5 South, (R) Sailwinds, (L) Crystal Bay, (L) Crois Court Lot #172

SUBDIVISION Windward Pointe BLOCK / SECTION 3 LOT 172 LOT AREA .66 Ac SITE CLASS. PS DESIGN FLOW 360 L.T.A.R. .35

Septic Tank: 1,000 Gallons; STB 313 Date 5/12/01
Pump Tank: 1,000 Gallons; PT 27 Date 4/25/01
Pump Make: Gould's Model WE0511M Serial No. 5019727
Nitrification Field: No Fields 1 Square Feet 1029 Linear Feet 343
No Lines 7@50 Trench Width 3' Max Trench Bottom Depth 30 Gravel Depth 12"

☒ New System ☐ Repair System Type: I, II, (III), IV, V, VI
System Description: Pump, Conventional
Repair System Description: Pump, 25% Reduction
Maintenance Agreement Required: ☐ Yes ☒ No

☐ House/Mod. Home ☒ Mobile Home ☐ Business ☐ Other
No. Bedrooms 3 No. Bathrooms 2 No. Employees


Water Supply: ☒ Individual ☐ Public ☐ Community

☐ Slab ☒ Crawl Space ☐ Basement w/plumbing ☐ Basement wo/plumbing

Comments:/Conditions: ① Do Not Install When Wet ② Keep 10ft from property lines ③ Keep well 100ft from System ④ After clearing lot possible Gravity Conv. System must have Health Dept. Approval.

Comments:/Conditions:

INITIAL SITE SKETCH Scale 1" = 50'

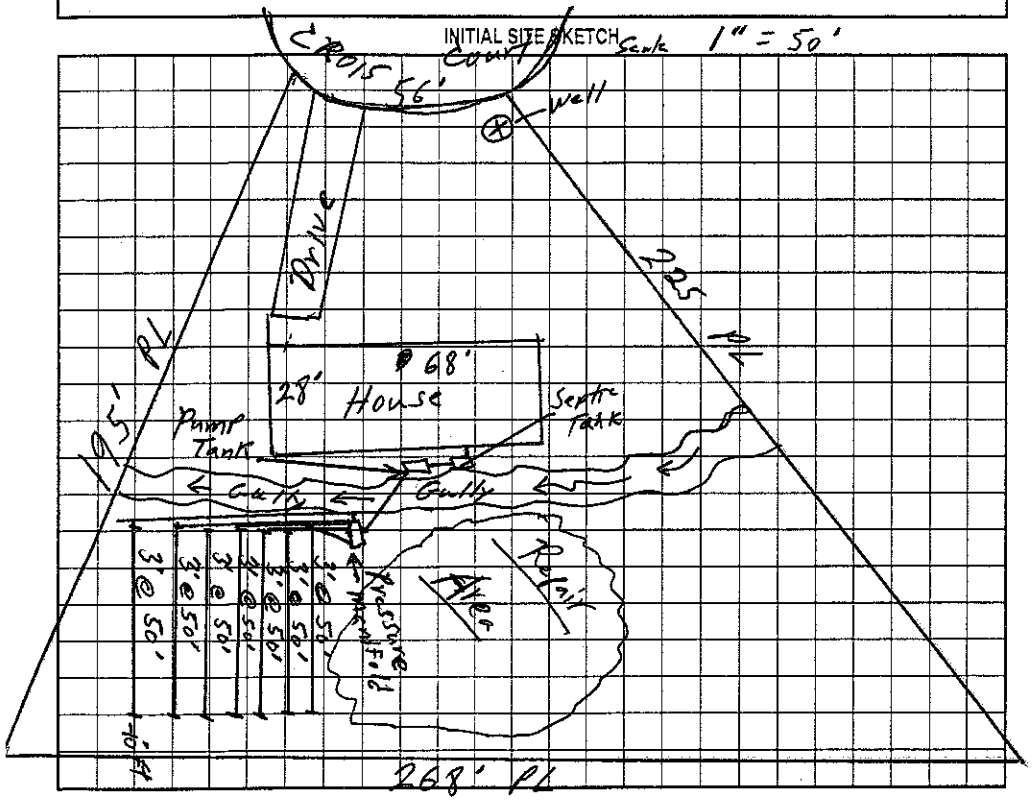

AS BUILT SKETCH

Permit can be suspended or revoked if any false information is supplied toward securing the permit/any unauthorized changes are made to the site/any unauthorized changes are made in the installation of the system. Improvement Permit with plat valid without expiration. Improvement Permit with site plan valid for sixty months. Authorization to Construct is valid for a period equal to that of Improvement Permit – not to exceed sixty months.

Signed: Emily Crouch date

Improvement Permit by: William O. Johnson RSI date 2/7/01

Authorization to Construct by: William O. Johnson RSI date 2/7/01

Installed by: Marty Tucker

Operation Permit by: Wesley Sparks RS. date 6/27/01

Existing System Inspection by: date

HEALTH DEPT. COPY: WHITE OWNER COPY (FINAL): YELLOW OWNER COPY (INITIAL): PINK