IREDELL COUNTY HEALTH DEPARTMENT

STATESVILLE 704-878-5305 125.00 Paid MOORESVILLE 704-664-5281

IMPROVEMENT PERMIT / AUTHORIZATION TO CONSTRUCT / OPERATION PERMIT / EXISTING SYSTEM INSPECTION

PERMIT# 93344 PIN# 4649 05 0597 DATE 2/12/01

OWNER OR CONTRACTOR Druitt Dev. Co. LLC / Fleetwood PHONE: Business 660-5903 Home

ADDRESS 142 Stutts Rd Mooresville NC 28117

LOCATION 115N, L Sailwinds, L Crystal Bay, R Cedar Springs, L Cro's ct, on Lt

SUBDIVISION Windward Pt. BLOCK / SECTION 3 LOT 173 LOT AREA 0.61AC SITE CLASS. PS DESIGN FLOW 360 L.T.A.R. 0.3

Septic Tank: 100 Gallons; STB 1012 Date 1/15/02

Pump Tank: Gallons; PT Date

Pump Make: Model Serial No.

Nitrification Field: No Fields 1 Square Feet 630 Linear Feet 210

No Lines 3@70' Trench Width 24"-36" Max Trench Bottom Depth 36" Gravel Depth —

☒ New System ☐ Repair System Type: I, II, (III), IV, V, VI

System Description: Gravity PPRS

Repair System Description: LPPRS

Maintenance Agreement Required: ☐ Yes ☒ No

☐ House/Mod. Home No. Bedrooms 3

☒ Mobile Home No. Bathrooms 2

☐ Business No. Employees

☐ Other


☐ Slab ☒ Crawl Space ☐ Basement w/plumbing ☐ Basement wo/plumbing

Water Supply: ☒ Individual ☐ Public ☐ Community

Comments/Conditions: ① Each line must be fed from multiple points at intervals Less than 50' Consult T+J Installation Manual about Distribution ② Keep well minimum 50' from System

Comments/Conditions: ③ Install Lines on Contour

INITIAL SITE SKETCH

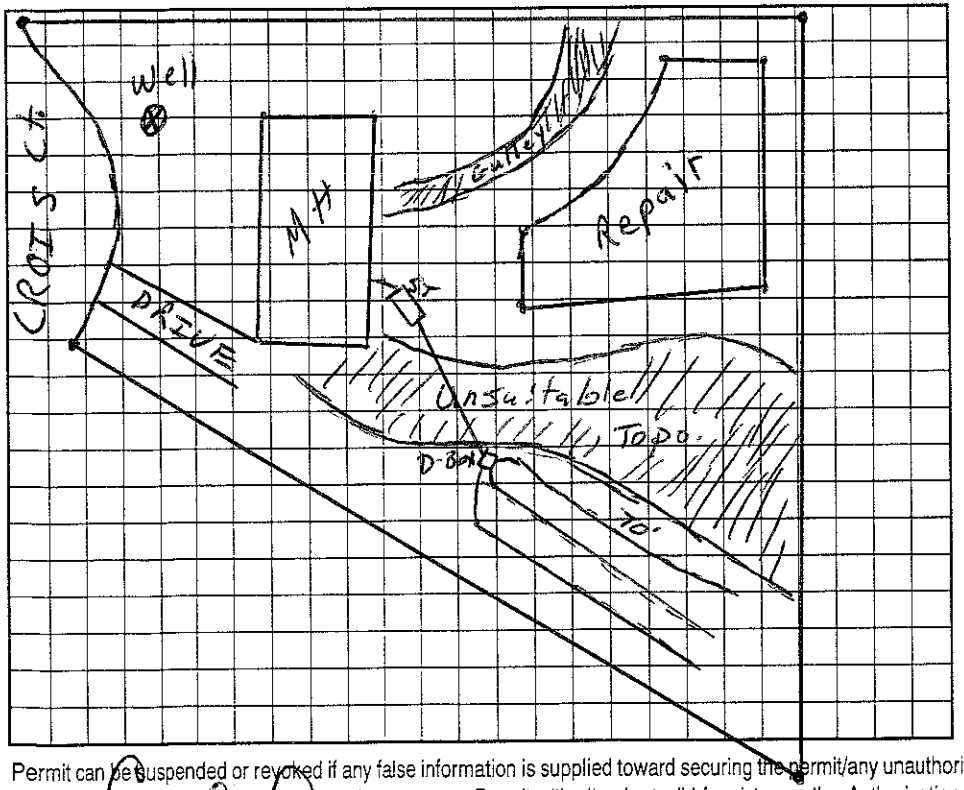

AS BUILT SKETCH

Permit can be suspended or revoked if any false information is supplied toward securing the permit/any unauthorized changes are made to the site/any unauthorized changes are made in the installation of the system. Improvement Permit with plat valid without expiration. Improvement Permit with site plan valid for sixty months. Authorization to Construct is valid for a period equal to that of Improvement Permit – not to exceed sixty months.

Signed: Emily Druitt date

Improvement Permit by: KSI date 2/12/01

Authorization to Construct by: RS date 5/16/02

Installed by: A-1 Back hoe

Operation Permit by: RS date 5/23/02

Existing System Inspection by: date

HEALTH DEPT. COPY: WHITE OWNER COPY (FINAL): YELLOW OWNER COPY (INITIAL): PINK