IREDELL COUNTY HEALTH DEPARTMENT

STATESVILLE 704-878-5305 MOORESVILLE 704-664-5281

IMPROVEMENT PERMIT / AUTHORIZATION TO CONSTRUCT / OPERATION PERMIT / EXISTING SYSTEM INSPECTION

PERMIT# 092082 PIN# ~~4659 06 8261 Pt.~~ 4659051282 DATE 2/9/01

OWNER OR CONTRACTOR Pruitt Development PHONE: Business 660-5963 Home

ADDRESS 142 Struts Rd. Mooresville, NC. 28117

LOCATION 115-21 N TL Sailwinds Tr Crystal Bay to end on R center of cul de sac

SUBDIVISION Diamond Point BLOCK / SECTION 3 LOT 189 LOT AREA ~.75Ac SITE CLASS. PS DESIGN FLOW 360 L.T.A.R. .3

Septic Tank: 1000 Gallons; STB 794 Date 9/7/00

Pump Tank: Gallons; PT Date

Pump Make: Model Serial No.

Nitrification Field: No Fields 1 Square Feet 900 Linear Feet 300

No Lines 4@75' Trench Width 3' Max Trench Bottom Depth 3' Gravel Depth No

[X] New System [ ] Repair System Type: I, II, III, IV, V, VI

System Description: Drop Box - Type 3 - 2590 Rock

Repair System Description: 5070 Rock - 16" PVC SDR 35

Maintenance Agreement Required: [ ] Yes [X] No

[X] House/Mod. Home No. Bedrooms 3

[ ] Mobile Home No. Bathrooms 3

[ ] Business No. Employees

[ ] Other

[ ] Slab [X] Crawl Space [ ] Basement w/plumbing [ ] Basement wo/plumbing


Water Supply: [X] Individual [ ] Public [ ] Community

Comments:/Conditions:


Comments:/Conditions:

(1" = 50')

INITIAL SITE SKETCH

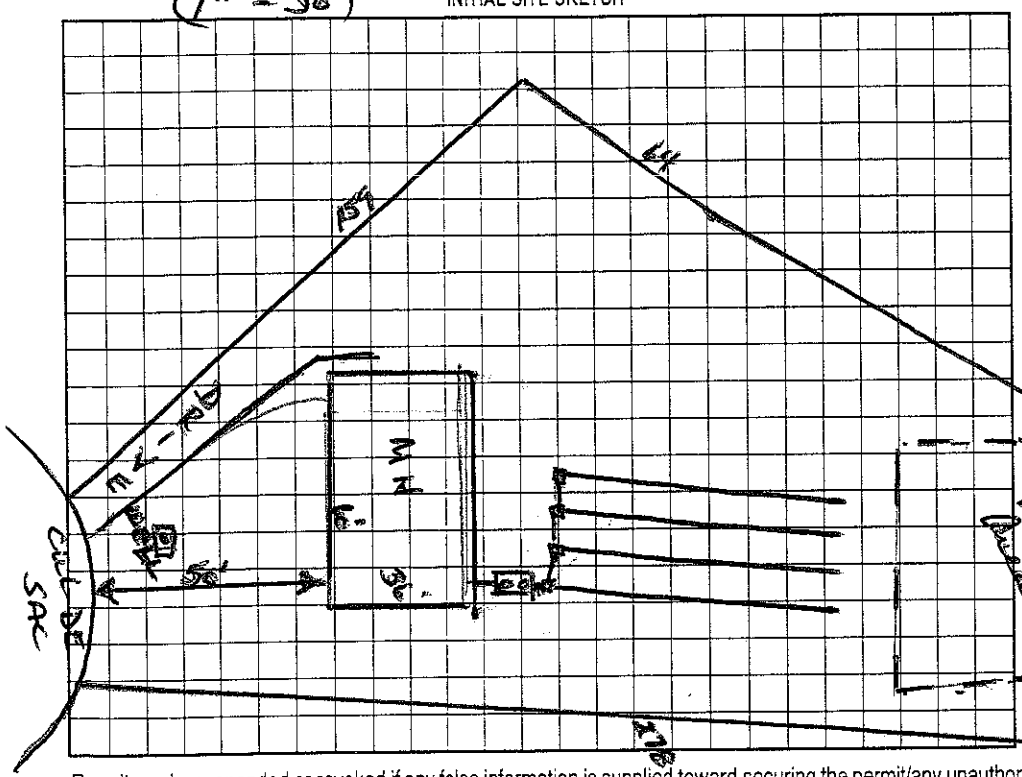

AS BUILT SKETCH

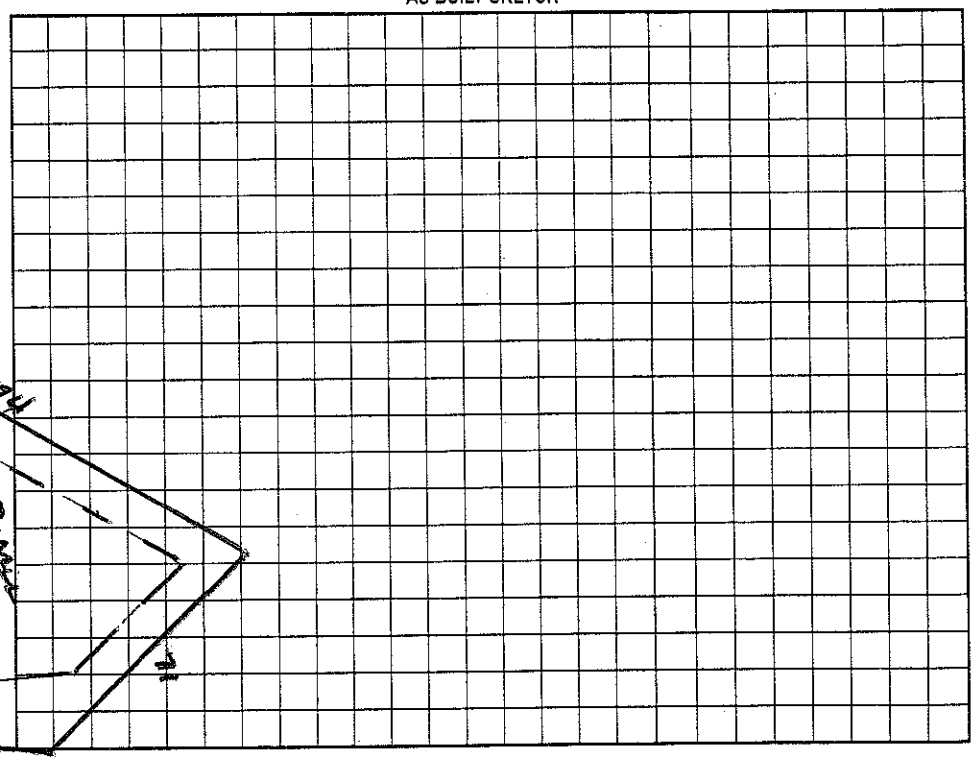

Permit can be suspended or revoked if any false information is supplied toward securing the permit/any unauthorized changes are made to the site/any unauthorized changes are made in the installation of the system. Improvement Permit with plat valid without expiration. Improvement Permit with site plan valid for sixty months. Authorization to Construct is valid for a period equal to that of Improvement Permit – not to exceed sixty months.

Signed: date

Improvement Permit by: Wesley Sparks RS date 2/9/01

Authorization to Construct by: Wesley Sparks RS. date 2/9/01

Installed by: Craig Thompson

Operation Permit by: Wesley Sparks RS. date 2/20/01

Existing System Inspection by: date

HEALTH DEPT. COPY: WHITE OWNER COPY (FINAL): YELLOW OWNER COPY (INITIAL): PINK