50.00 Paid 11:30

IREDELL COUNTY HEALTH DEPARTMENT

STATESVILLE 704-878-5305 MOORESVILLE 704-664-5281

IMPROVEMENT PERMIT / AUTHORIZATION TO CONSTRUCT / OPERATION PERMIT / EXISTING SYSTEM INSPECTION

PERMIT# 93348 PIN# 4659 05 1791 DATE 6/12/01

OWNER OR CONTRACTOR Pruitt Dev. PHONE: Business 660-5903 Home

ADDRESS 142 Stutts Rd Mooresville NC 28117

LOCATION 115N, LSgallwinds, L Crystal Bay, R Clear Springs on Lt 209 Clear Springs Rd

SUBDIVISION Windward Pt. BLOCK / SECTION 3 LOT 176 LOT AREA 1.12 AC SITE CLASS PS DESIGN FLOW 480 L.T.A.R. 0.5

Septic Tank: 1600 Gallons; STB 1012 Date 10/5/01

Pump Tank: ~~1000~~ Gallons; PT Date

Pump Make: Model Serial No.

Nitrification Field: No Fields 1 Square Feet 1200 Linear Feet 400

No Lines 6 Trench Width 36" Max Trench Bottom Depth 36" Gravel Depth —

☒ New System ☐ Repair System Type: I, II, (III), IV, V, VI

System Description: Pump to 25% Reduction

Repair System Description: LPPBS

Maintenance Agreement Required: ☐ Yes ☒ No

☐ House/Mod. Home ☒ Mobile Home ☐ Business ☐ Other

No. Bedrooms 4 No. Bathrooms 2 No. Employees

☐ Slab ☒ Crawl Space ☐ Basement w/plumbing ☐ Basement wo/plumbing


Water Supply: ☒ Individual ☐ Public ☐ Community

Comments:/Conditions: Install lines on Contour - keep 50' minimum from Septic System


Comments:/Conditions:

EXISTING DONE IN 2009 JA

INITIAL SITE SKETCH

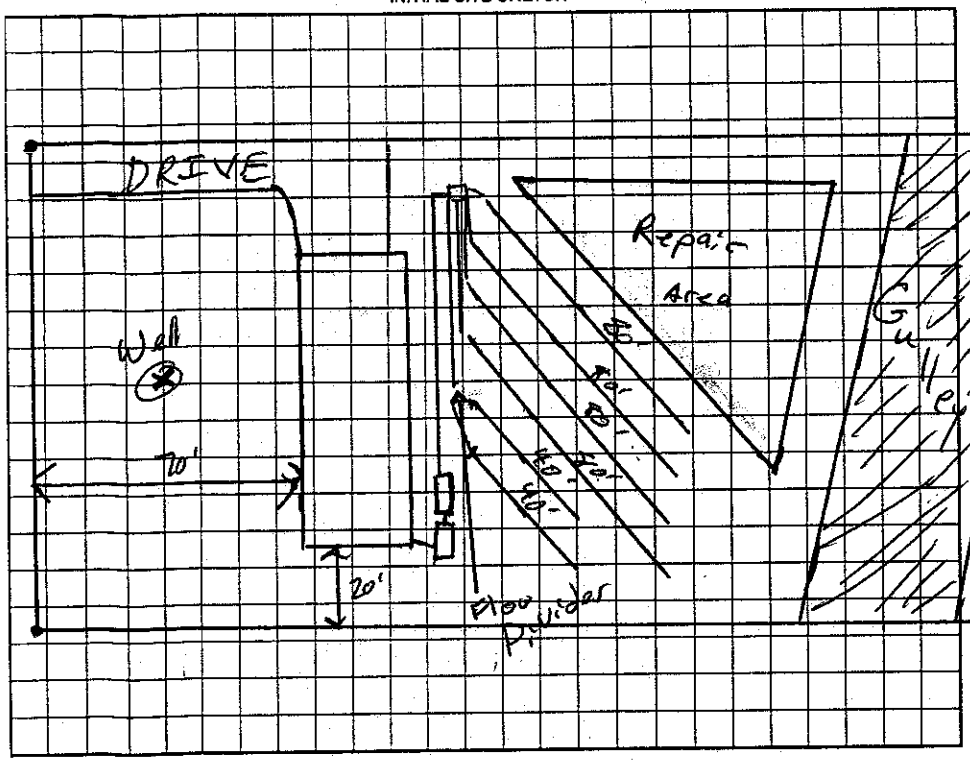

AS BUILT SKETCH

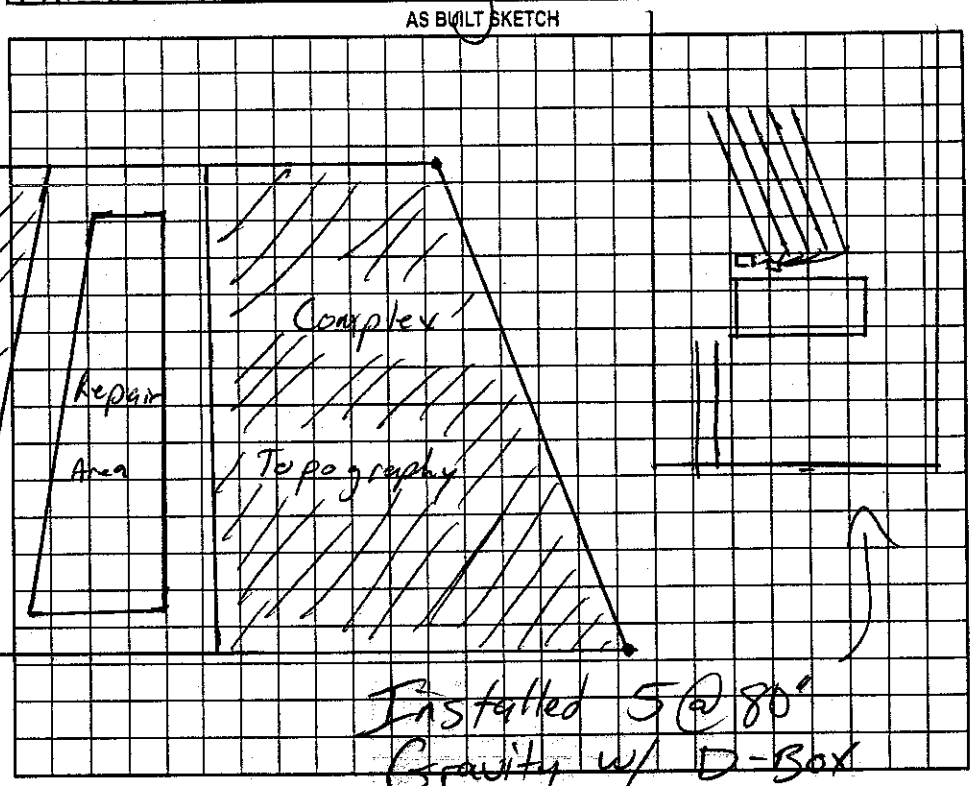

Permit can be suspended or revoked if any false information is supplied toward securing the permit/any unauthorized changes are made to the site/any unauthorized changes are made in the installation of the system. Improvement Permit with plat valid without expiration. Improvement Permit with site plan valid for sixty months. Authorization to Construct is valid for a period equal to that of Improvement Permit – not to exceed sixty months.

Signed: date 6/14/01 Installed by: A-1 Backhoe

Improvement Permit by: RSE date 6/12/01 Operation Permit by: RSE date 2/22/02

Authorization to Construct by: RSE date 6/12/01 Existing System Inspection by: date