IREDELL COUNTY HEALTH DEPARTMENT

STATESVILLE 704-878-5305 Paid 125.00 DT MOORESVILLE 704-664-5281

IMPROVEMENT PERMIT / AUTHORIZATION TO CONSTRUCT / OPERATION PERMIT / EXISTING SYSTEM INSPECTION

PERMIT# 092081 PIN# ~~4659068261 Pt.~~ 4659052329 DATE 10/27/00

OWNER OR CONTRACTOR Pruitt Dev. Co. PHONE: Business 660-5903 Home

ADDRESS 142 Stutts Rd. Mooresville, NC 28117

LOCATION 115 N TL Sailwinds TL Crystal Bay, to cul de sac on (R)

SUBDIVISION Winward Point BLOCK / SECTION 3 LOT 188 LOT AREA .71 AC SITE CLASS. PS DESIGN FLOW 480 L.T.A.R. .3

Septic Tank: 1000 Gallons; STB 312 Date 8/7/00
Pump Tank: Gallons; PT Date
Pump Make: Model Serial No.
Nitrification Field: No Fields 1 Square Feet 1200 * Linear Feet 400 *
No Lines 6 @ 67' Trench Width 3' Max Trench Bottom Depth 3' Gravel Depth

[X] New System [ ] Repair System Type: I, II, (III), IV, V, VI
System Description: Recommend EZ Flow *
Repair System Description: 16" PPBS
Maintenance Agreement Required: [ ] Yes [X] No

[X] House/Mod. Home [ ] Mobile Home [ ] Business [ ] Other
No. Bedrooms 4 No. Bathrooms 2 No. Employees


[ ] Slab [ ] Crawl Space [ ] Basement w/plumbing [ ] Basement wo/plumbing

Water Supply: [X] Individual [ ] Public [ ] Community

Comments:/Conditions:

Comments:/Conditions: * Bending Contours recommend EZ Flow *

INITIAL SITE SKETCH (1" = 50')

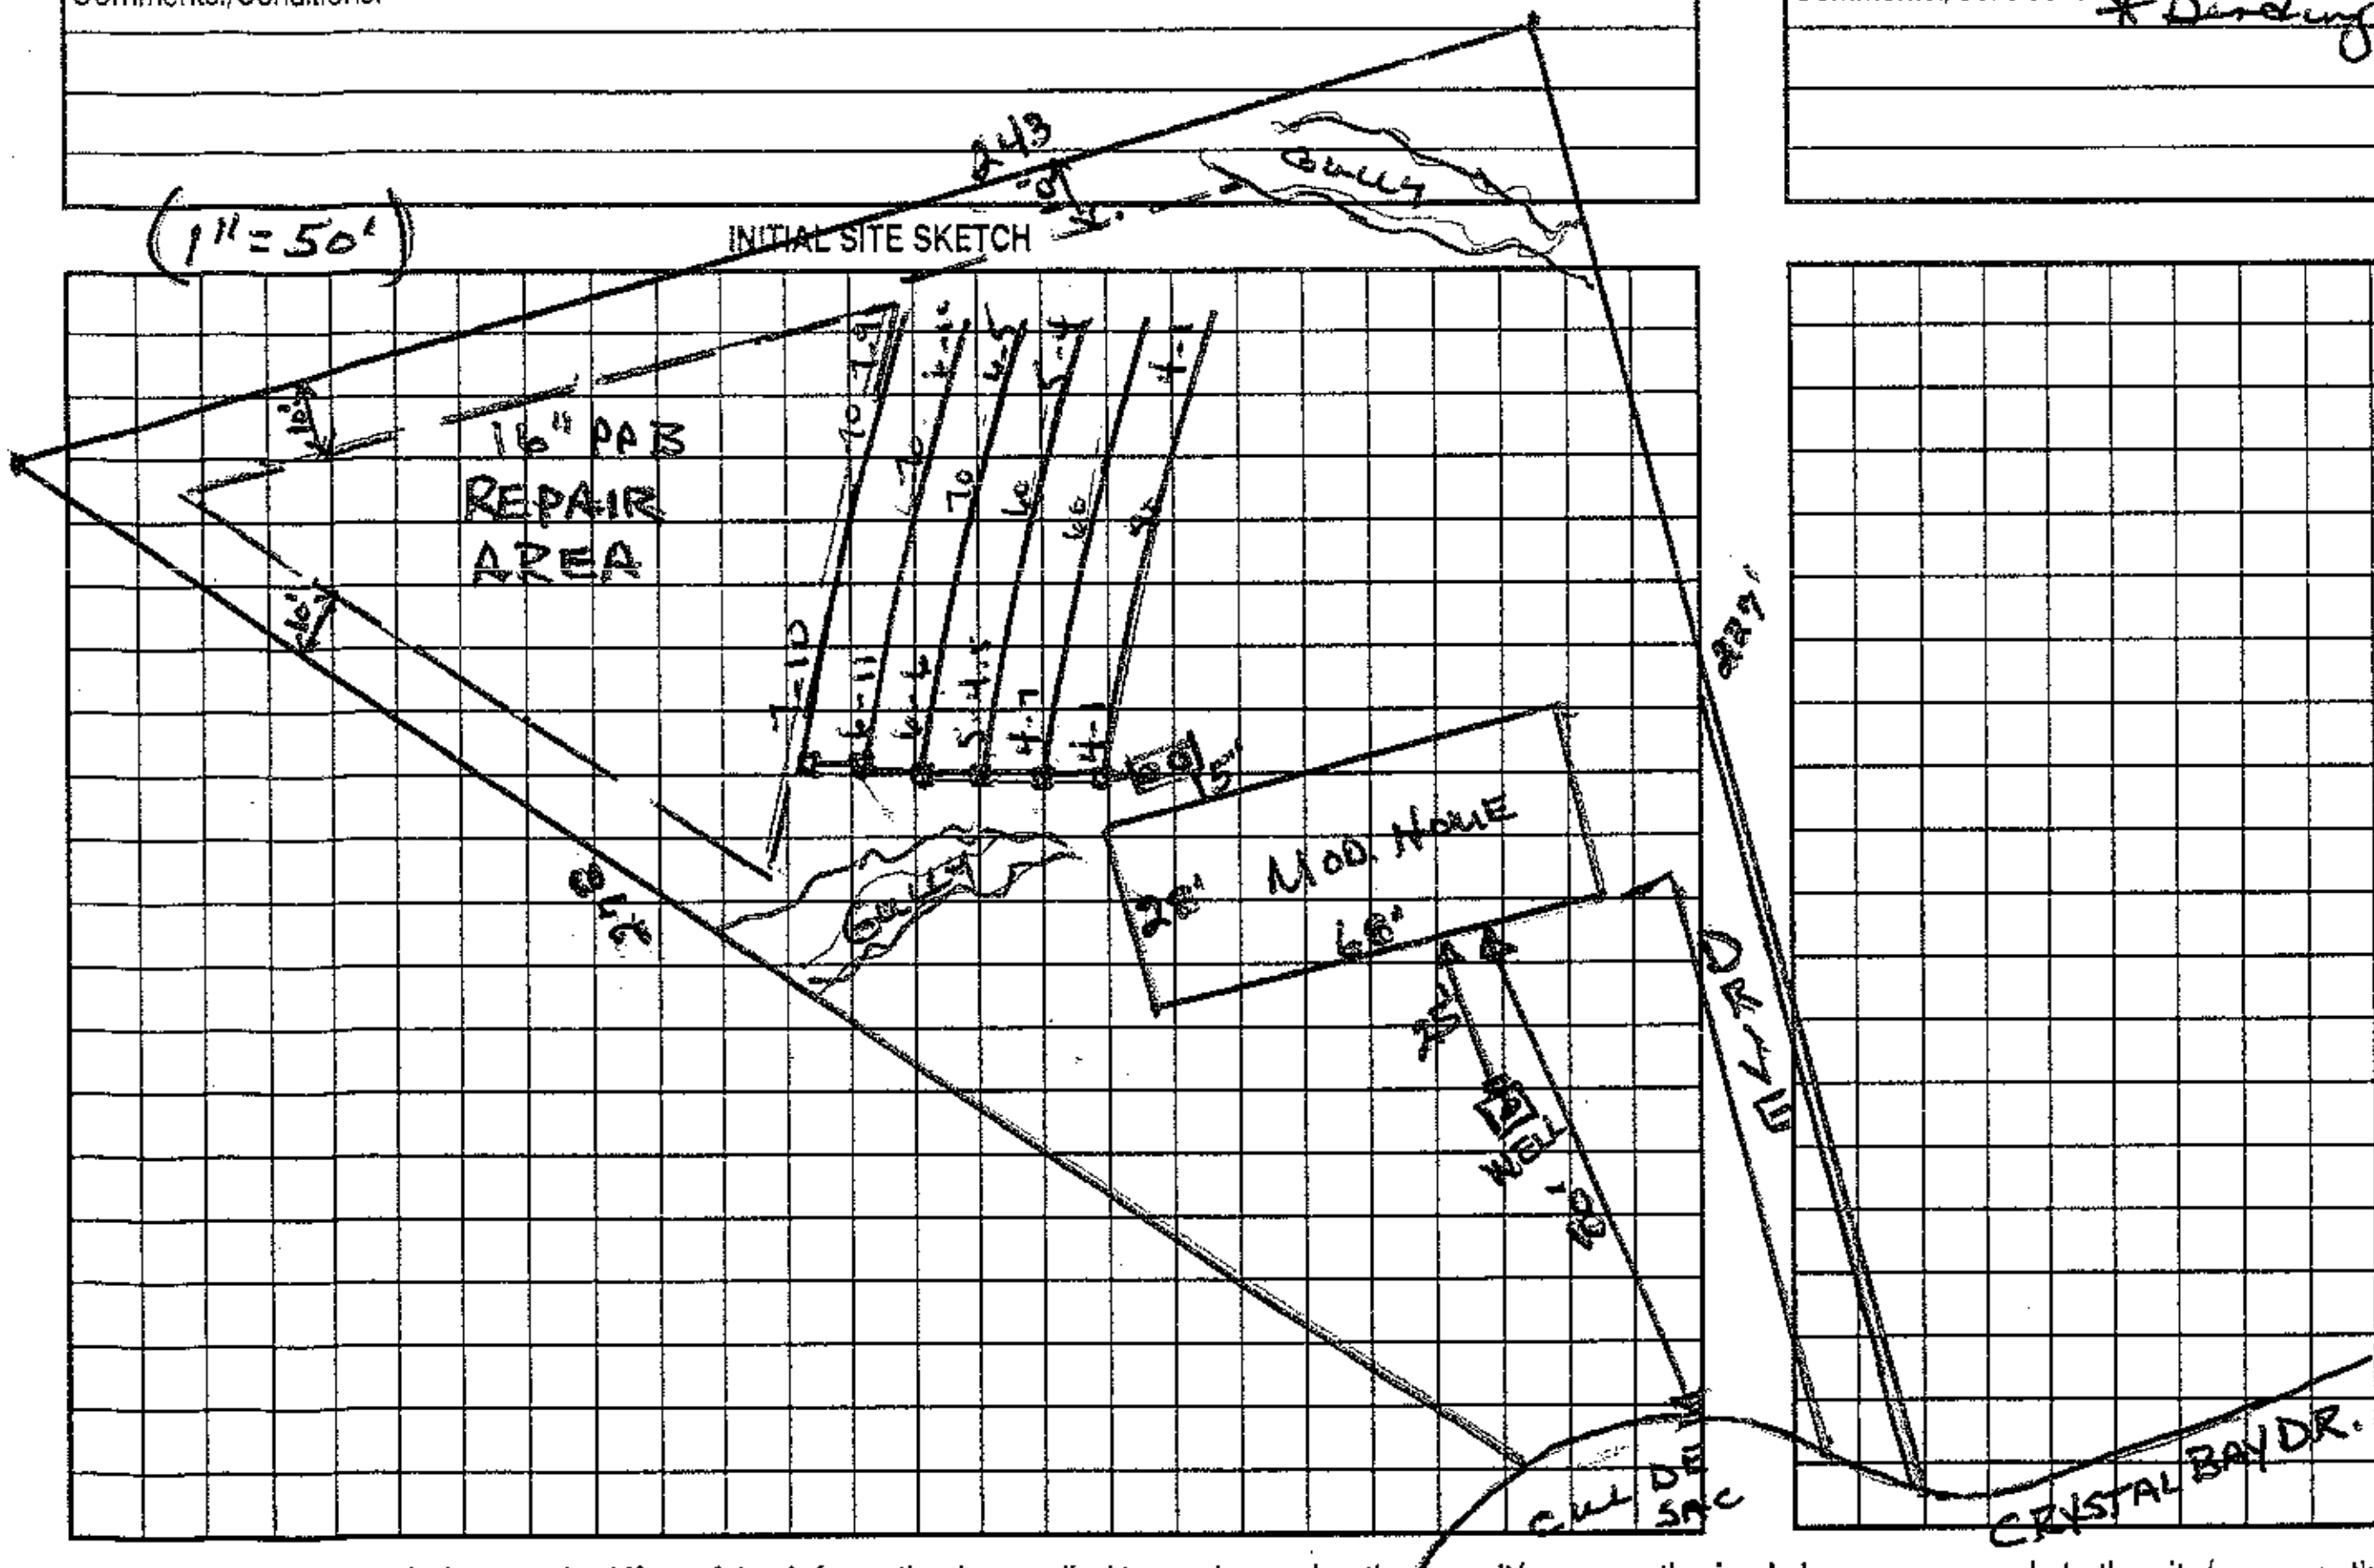

AS BUILT SKETCH

Permit can be suspended or revoked if any false information is supplied toward securing the permit/any unauthorized changes are made to the site/any unauthorized changes are made in the installation of the system. Improvement Permit with plat valid without expiration. Improvement Permit with site plan valid for sixty months. Authorization to Construct is valid for a period equal to that of Improvement Permit – not to exceed sixty months.

Signed: * [signature] date 11/01/00 Installed by: Marty Tucker

Improvement Permit by: Wesley Sparks R.S. date 10/27/00 Operation Permit by: Wesley Sparks R.S. date 11/5/01

Authorization to Construct by: Wesley Sparks R.S. date 10/27/00 Existing System Inspection by: date

HEALTH DEPT. COPY: WHITE OWNER COPY (FINAL): YELLOW OWNER COPY (INITIAL): PINK