IREDELL COUNTY HEALTH DEPARTMENT

STATESVILLE 704-878-5305 125.00 Paid MOORESVILLE 704-664-5281

IMPROVEMENT PERMIT / AUTHORIZATION TO CONSTRUCT / OPERATION PERMIT / EXISTING SYSTEM INSPECTION

PERMIT# 101077 PIN# 4659-05-3434 DATE 7/24/01

OWNER OR CONTRACTOR Pruitt Dev. Co. PHONE: Business 660-5900 Home

ADDRESS 142 Stutts Rd. Mooresville NC 28117

LOCATION 115 N, TL Sail Winds, TL Crystal Bay, on Rt. at Cathedral

SUBDIVISION Windward Pt BLOCK / SECTION 3 LOT 187 LOT AREA 0.52 AC SITE CLASS. PS DESIGN FLOW 360 L.T.A.R. 0.3

Septic Tank: 1000 Gallons; STB 760 Date 8/26/01
Pump Tank: Gallons; PT Date
Pump Make: Model Serial No.
Nitrification Field: No Fields 1 Square Feet 900 Linear Feet 300
No Lines 3@100' Trench Width 36" Max Trench Bottom Depth 36"

☒ New System ☐ Repair System Type: I, II, (III) IV, V, VI
System Description: Gravity 25% Reduction
Repair System Description: Gravity/Pump Panel
Maintenance Agreement Required: ☐ Yes ☒ No
Gravel Depth —
☐ Slab ☒ Crawl Space ☐ Basement w/plumbing ☐ Basement wo/plumbing


☐ House/Mod. Home No. Bedrooms 3
☒ Mobile Home No. Bathrooms 2
☐ Business No. Employees
☐ Other

Water Supply: ☒ Individual ☐ Public ☐ Community

Comments:/Conditions:

Comments:/Conditions:

INITIAL SITE SKETCH

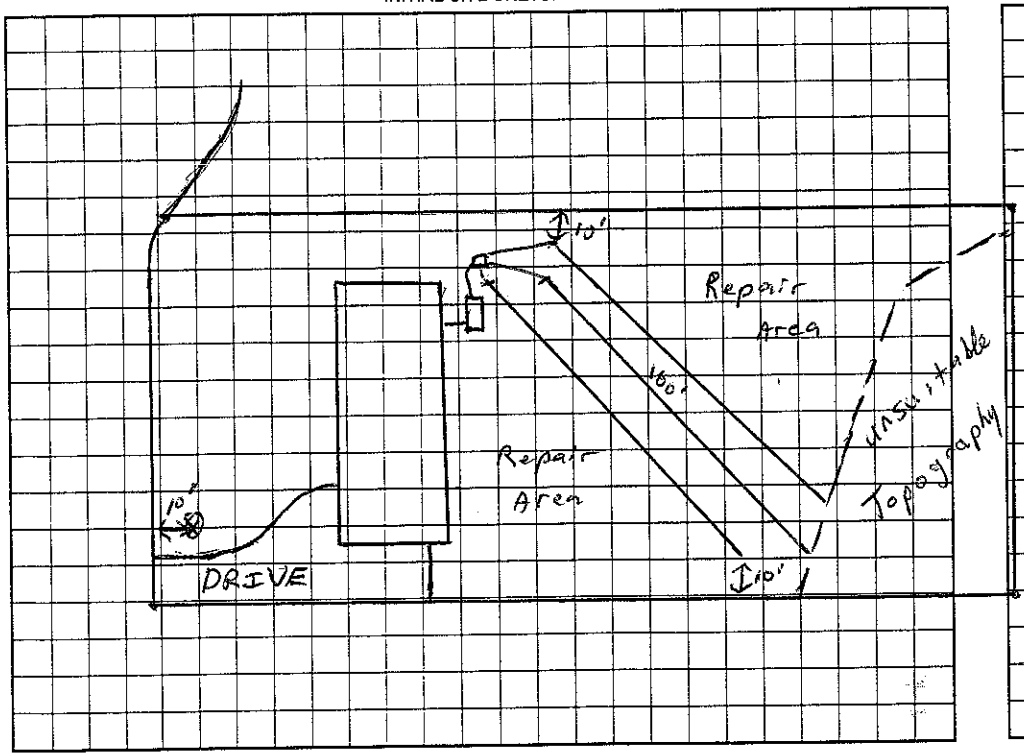

AS BUILT SKETCH

Installed As Drawn (Infiltrators)

Permit can be suspended or revoked if any false information is supplied toward securing the permit/any unauthorized changes are made to the site/any unauthorized changes are made in the installation of the system. Improvement Permit with plat valid without expiration. Improvement Permit with site plan valid for sixty months. Authorization to Construct is valid for a period equal to that of Improvement Permit – not to exceed sixty months.

Signed: date 7/27/01 Installed by: Dunn Grading

Improvement Permit by: RSI date 7/24/01 Operation Permit by: RSI date 10/24/01

Authorization to Construct by: RSI date 7/24/01 Existing System Inspection by: date

HEALTH DEPT. COPY: WHITE OWNER COPY (FINAL): YELLOW OWNER COPY (INITIAL): PINK