IREDELL COUNTY HEALTH DEPARTMENT

STATESVILLE 704-878-5305 125.00 Paid 2100 MOORESVILLE 704-664-5281 Marty Tucker

IMPROVEMENT PERMIT / AUTHORIZATION TO CONSTRUCT / OPERATION PERMIT / EXISTING SYSTEM INSPECTION

PERMIT# 101076 PIN# 4659-05-4502 DATE 7/20/01

OWNER OR CONTRACTOR Pruitt Dev. Co. LLC PHONE: Business 660-5900 Home

ADDRESS 142 Stutts Rd Mooresville NC 28117

LOCATION 115N, TL Sailwinds, TL Crystal Bay on RT

SUBDIVISION Windward Pt BLOCK / SECTION 3 LOT 186 LOT AREA 0.55Ac SITE CLASS. P5 DESIGN FLOW 360 L.T.A.R. 0.5

Septic Tank: 1000 Gallons; STB 794 Date 12/11/01
Pump Tank: ____ Gallons; PT ____ Date ____
Pump Make: ____ Model ____ Serial No. ____
Nitrification Field: No Fields 1 Square Feet 600 Linear Feet 200
No Lines 4@50' Trench Width 24"-36" Max Trench Bottom Depth 36" Gravel Depth ____

☒ New System ☐ Repair System Type: I, II, (III), IV, V, VI
System Description: Gravity Panel
Repair System Description: Same
Maintenance Agreement Required: ☐ Yes ☒ No


☐ House/Mod. Home No. Bedrooms 3
☒ Mobile Home No. Bathrooms 2
☐ Business No. Employees ____
☐ Other ____
☐ Slab ☒ Crawl Space ☐ Basement w/plumbing ☐ Basement wo/plumbing

Water Supply:
☒ Individual
☐ Public
☐ Community


Comments:/Conditions: Install Lines on Contour - keep well minimum 50' from septic system

Comments:/Conditions:

INITIAL SITE SKETCH

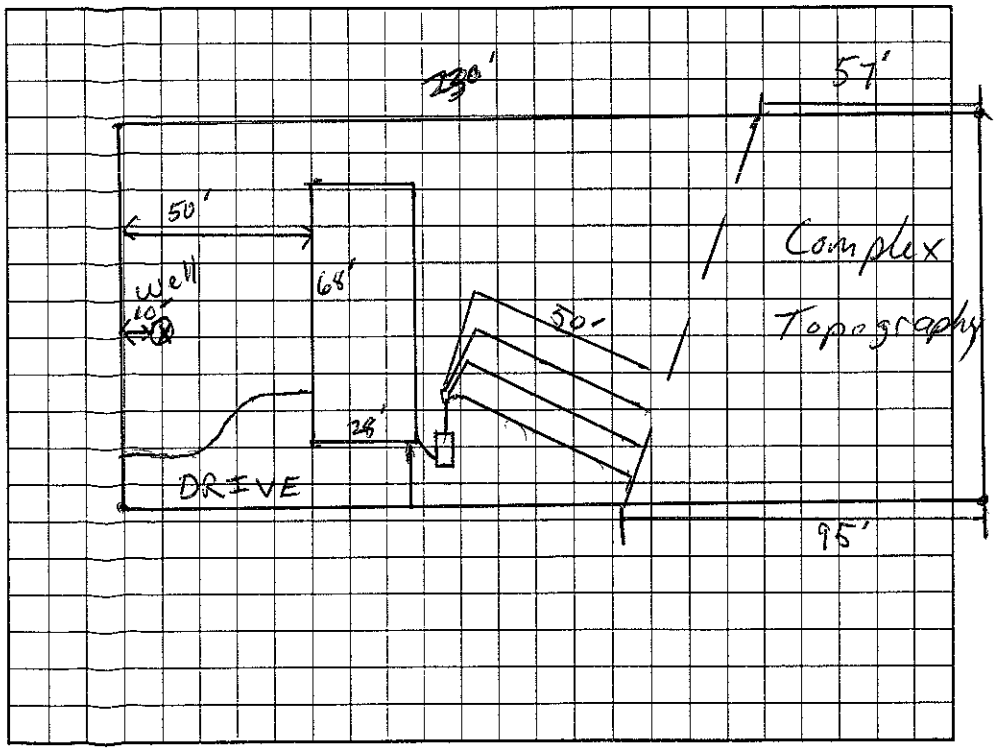

AS BUILT SKETCH

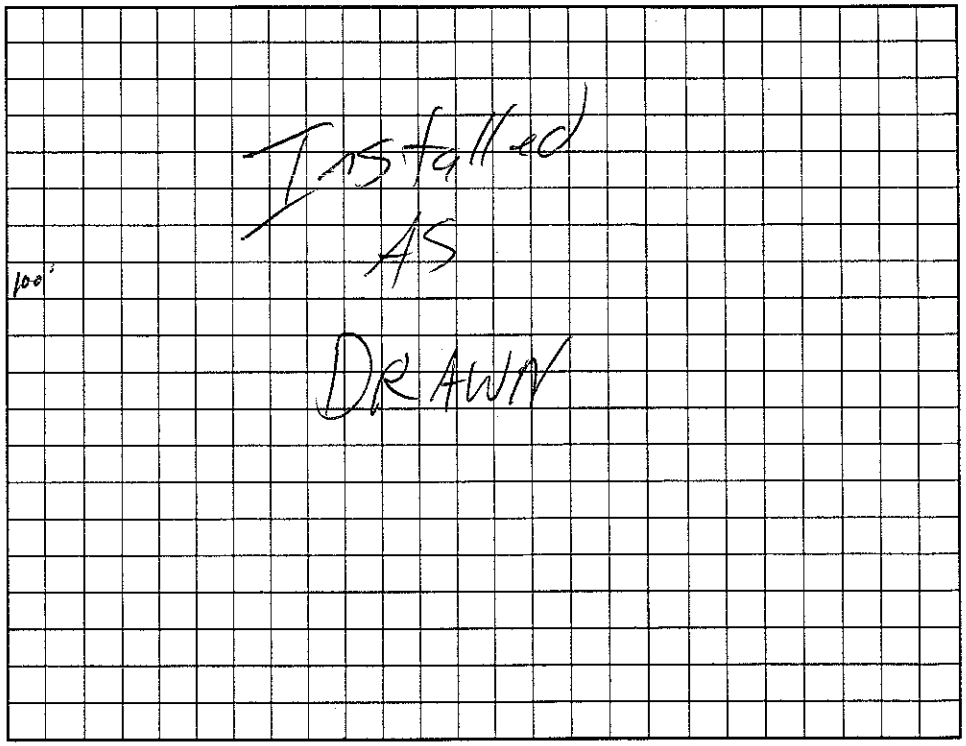

Permit can be suspended or revoked if any false information is supplied toward securing the permit/any unauthorized changes are made to the site/any unauthorized changes are made in the installation of the system. Improvement Permit with plat valid without expiration. Improvement Permit with site plan valid for sixty months. Authorization to Construct is valid for a period equal to that of Improvement Permit – not to exceed sixty months.

Signed: ____ date 7/27/01
Improvement Permit by: ____ RSI date 7/20/01
Authorization to Construct by: ____ RSI date 7/20/01

Installed by: Marty Tucker
Operation Permit by: ____ RS date 1/31/02
Existing System Inspection by: ____ date ____

HEALTH DEPT. COPY: WHITE OWNER COPY (FINAL): YELLOW OWNER COPY (INITIAL): PINK