IREDELL COUNTY HEALTH DEPARTMENT

STATESVILLE 704-878-5305 50.00 Paid MOORESVILLE 704-664-5281 11:00

IMPROVEMENT PERMIT / AUTHORIZATION TO CONSTRUCT / OPERATION PERMIT / EXISTING SYSTEM INSPECTION

PERMIT# 90991 PIN# ~~4659065264~~ 4659054579 DATE 5/16/01

OWNER OR CONTRACTOR Pruitt Dev. Co PHONE: Business 663-6700 Home

ADDRESS 142 Stutts Rd Mooresville NC 28117

LOCATION 21 N & Soil winds, L Crystal Bay to Clearsprings on Rt

SUBDIVISION Windward PT BLOCK / SECTION 3 LOT 185 LOT AREA 0.55 A SITE CLASS PS DESIGN FLOW 450 L.T.A.R. 0.5

Septic Tank: 1000 Gallons; STB 1012 Date 3/14/01
Pump Tank: ____ Gallons; PT ____ Date ____
Pump Make: ____ Model ____ Serial No. ____
Nitrification Field: No Fields 1 Square Feet 1200 Linear Feet 400
No Lines 4 @ 100 Trench Width 36" Max Trench Bottom Depth 36" Gravel Depth ____

☒ New System ☐ Repair System Type: I, II, III, IV, V, VI
System Description: Gravity 25% Red
Repair System Description: LPP panel
Maintenance Agreement Required: ☐ Yes ☒ No

☒ House/Mod. Home No. Bedrooms 4
☒ Mobile Home No. Bathrooms 3
☐ Business No. Employees ____
☐ Other ____


☐ Slab ☒ Crawl Space ☐ Basement w/plumbing ☐ Basement wo/plumbing

Water Supply: ☒ Individual ☐ Public ☐ Community


Comments:/Conditions:

Comments:/Conditions:

INITIAL SITE SKETCH

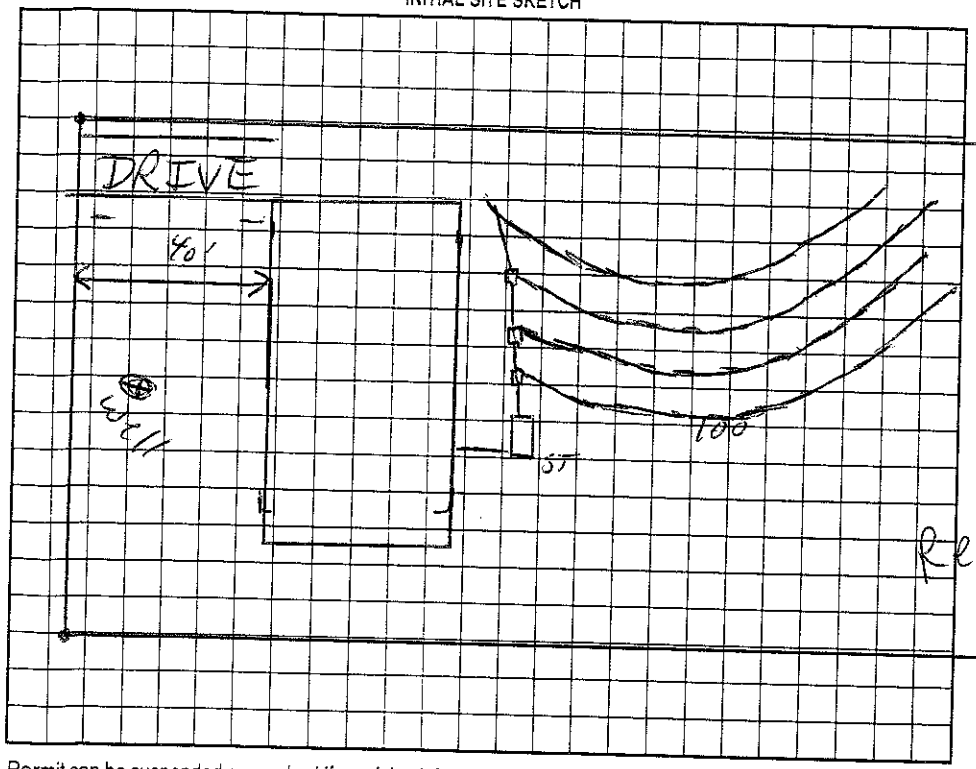

AS BUILT SKETCH

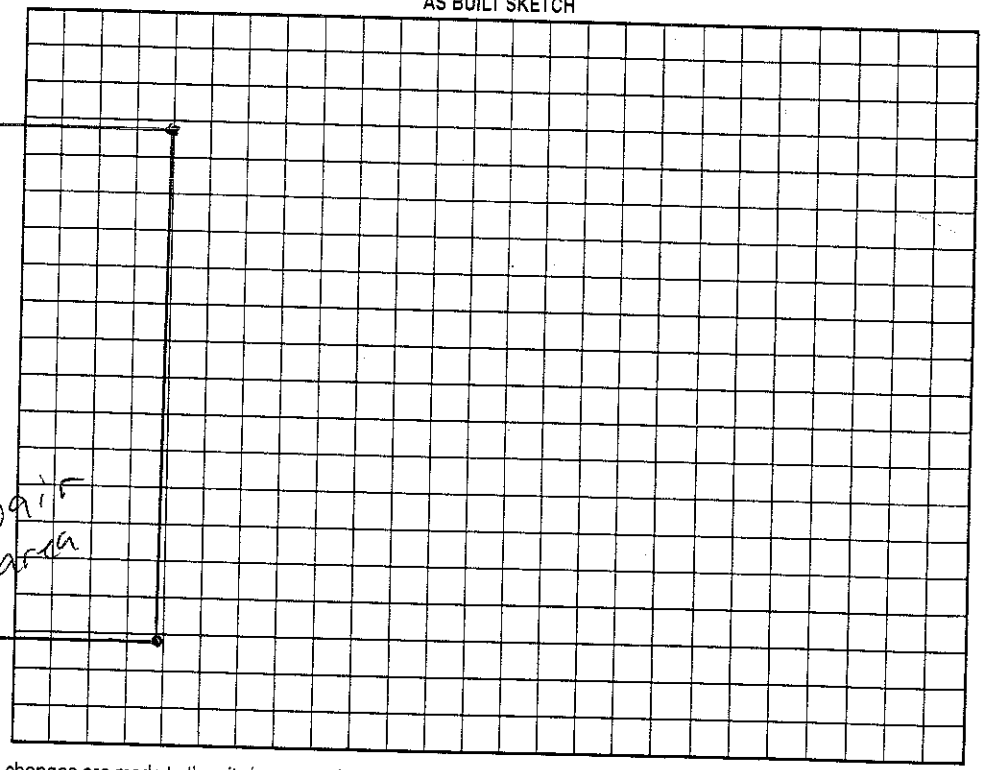

Permit can be suspended or revoked if any false information is supplied toward securing the permit/any unauthorized changes are made to the site/any unauthorized changes are made in the installation of the system. Improvement Permit with plat valid without expiration. Improvement Permit with site plan valid for sixty months. Authorization to Construct is valid for a period equal to that of Improvement Permit – not to exceed sixty months.

Signed: R. Lynn Davis date 5-15-01 Installed by: A-1 Backhoe

Improvement Permit by: RSI date 5/16/01 Operation Permit by: RSI date 5/24/01

Authorization to Construct by: RSI date 5/16/01 Existing System Inspection by: ____ date ____

HEALTH DEPT. COPY: WHITE OWNER COPY (FINAL): YELLOW OWNER COPY (INITIAL): PINK