IREDELL COUNTY HEALTH DEPARTMENT

STATESVILLE 704-878-5305 — MOORESVILLE 704-664-5281

IMPROVEMENT PERMIT / AUTHORIZATION TO CONSTRUCT / OPERATION PERMIT / EXISTING SYSTEM INSPECTION

PERMIT# 090989 PIN# ~~4659068261~~ ~~4664~~ 4659055647 DATE 8/21/00

OWNER OR CONTRACTOR Pruitt Dev. Co. PHONE: Business (704) 663-6700 Home

ADDRESS 142 Stutts Rd Mooresville NC 28117

LOCATION 21 N, L Sail Winds, L Crystal Bay, R to Clear Springs on Rt

SUBDIVISION Windward Pt BLOCK / SECTION 3 LOT 184 LOT AREA .55 SITE CLASS PS DESIGN FLOW 360 L.T.A.R. 0.3

Septic Tank: 1000 Gallons; STB 1012 Date 2/2/00
Pump Tank: ____ Gallons; PT ____ Date ____
Pump Make: ____ Model ____ Serial No. ____
Nitrification Field: No Fields 1 Square Feet 1200 Linear Feet 400
No Lines 3@133' Trench Width 36" Max Trench Bottom Depth 36" Gravel Depth 12"

☒ New System ☐ Repair System Type: I, II, III, IV, V, VI
System Description: Gravity Conventional
Repair System Description: Same
Maintenance Agreement Required: ☐ Yes ☒ No


☒ House/Mod. Home No. Bedrooms 3
☐ Mobile Home No. Bathrooms 2
☐ Business No. Employees ____
☐ Other ____
☐ Slab ☒ Crawl Space ☐ Basement w/plumbing ☐ Basement wo/plumbing

Water Supply: ☒ Individual ☐ Public ☐ Community


Comments:/Conditions: Keep well 50' from Septic System

Comments:/Conditions:

INITIAL SITE SKETCH

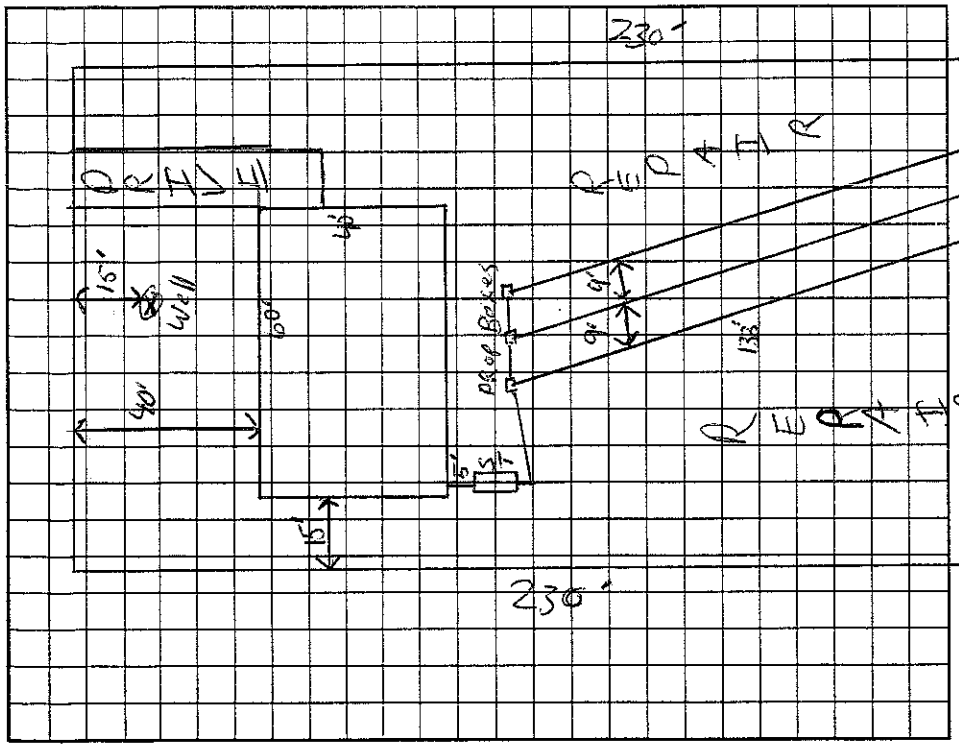

AS BUILT SKETCH

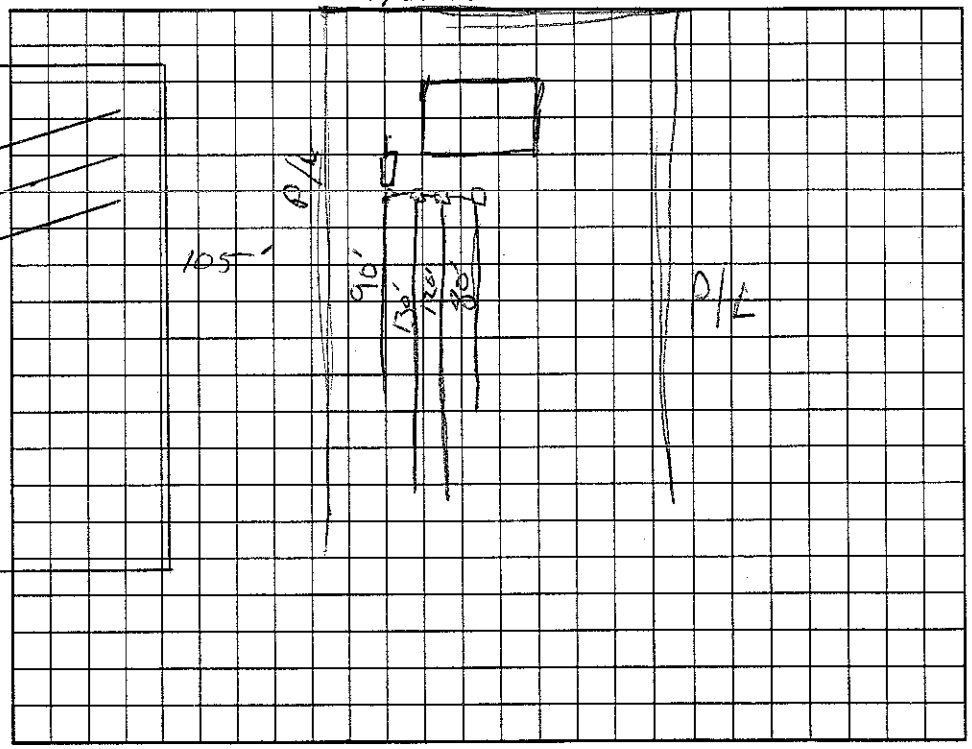

Permit can be suspended or revoked if any false information is supplied toward securing the permit/any unauthorized changes are made to the site/any unauthorized changes are made in the installation of the system. Improvement Permit with plat valid without expiration. Improvement Permit with site plan valid for sixty months. Authorization to Construct is valid for a period equal to that of Improvement Permit -- not to exceed sixty months.

Signed: ____ date 9/8/00 Installed by: A-1 Backhoe

Improvement Permit by: [signature] RST date 8/21/00 Operation Permit by: [signature] RST date 4/11/01

Authorization to Construct by: [signature] RST date 8/21/00 Existing System Inspection by: ____ date ____

HEALTH DEPT. COPY: WHITE OWNER COPY (FINAL): YELLOW OWNER COPY (INITIAL): PINK