IREDELL COUNTY HEALTH DEPARTMENT

STATESVILLE 704-878-5305 125.00 Paid MOORESVILLE 704-664-5281

IMPROVEMENT PERMIT / AUTHORIZATION TO CONSTRUCT / OPERATION PERMIT / EXISTING SYSTEM INSPECTION

PERMIT# 93350 PIN# 4659 05 6734 DATE 2/12/01

OWNER OR CONTRACTOR Pruitt Dev. Co. LLC / Andy Gabriel PHONE: Business 660-5903 Home 704-528-3320

ADDRESS 142 Stutts Rd Mooresville NC 28115

LOCATION 115 N. L Sail winds, L Crystal Bay on Rt

SUBDIVISION Wind Ward Pt. BLOCK / SECTION 3 LOT 183 LOT AREA .55 AC SITE CLASS. PS DESIGN FLOW 480 L.T.A.R. 0.35

Septic Tank: 1000 Gallons; STB 794 Date 2/9/02
Pump Tank: 1000 Gallons; PT 27 Date 5/4/02
Pump Make: Goulds Model WE03311M Serial No.
Nitrification Field: No Fields 1 Square Feet 1035 Linear Feet 345
No Lines 3@115' Trench Width 36" Max Trench Bottom Depth 36" Gravel Depth —

☒ New System ☐ Repair System Type: I, II, (III), IV, V, VI
System Description: Press. Man. 25% Reduction
Repair System Description: LPPP85
Maintenance Agreement Required: ☐ Yes ☒ No

☒ House/Mod. Home ☒ Mobile Home ☐ Business ☐ Other
No. Bedrooms 4 No. Bathrooms 2 No. Employees


Water Supply: ☒ Individual ☐ Public ☐ Community

☐ Slab ☒ Crawl Space ☐ Basement w/plumbing ☐ Basement wo/plumbing

Comments:/Conditions: ① Install Line on Contour
② Keep well 50' from system

Comments:/Conditions:

INITIAL SITE SKETCH

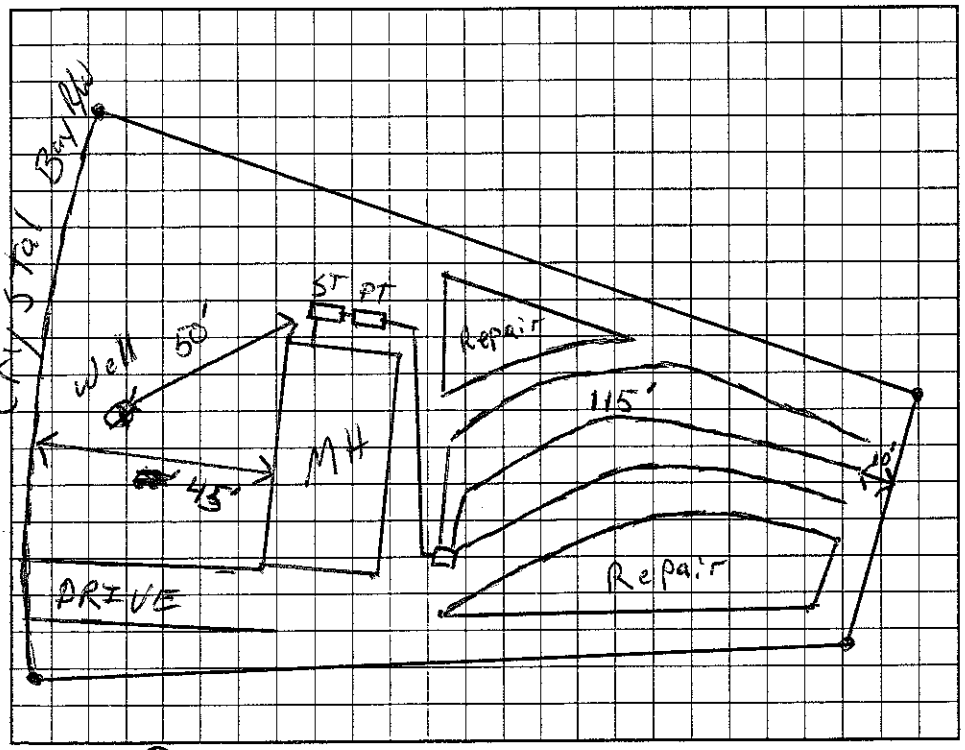

AS BUILT SKETCH

Permit can be suspended or revoked if any false information is supplied toward securing the permit/any unauthorized changes are made to the site/any unauthorized changes are made in the installation of the system. Improvement Permit with plat valid without expiration. Improvement Permit with site plan valid for sixty months. Authorization to Construct is valid for a period equal to that of Improvement Permit – not to exceed sixty months.

Signed: Emily Crouch date

Improvement Permit by: RSI date 2/12/01

Authorization to Construct by: RS date 5/9/02

Installed by: Monty Tucker

Operation Permit by: Wesley Sparks RS date 8/15/02

Existing System Inspection by: date

HEALTH DEPT. COPY: WHITE OWNER COPY (FINAL): YELLOW OWNER COPY (INITIAL): PINK