IREDELL COUNTY HEALTH DEPARTMENT

STATESVILLE 704-878-5305 MOORESVILLE 704-664-5281

IMPROVEMENT PERMIT / AUTHORIZATION TO CONSTRUCT / OPERATION PERMIT / EXISTING SYSTEM INSPECTION

PERMIT# 093349 PIN# 4659-05-6845 DATE 5/30/02

OWNER OR CONTRACTOR Vander Built West PHONE: Business 704 528 3320 Home

ADDRESS 849 S. Main ST Troutman 28166

LOCATION 21 N. TL SAILWINDS TL Crystal Bay, on RT 1660 Crystal Bay Dr.

SUBDIVISION Windward Pt BLOCK / SECTION 3 LOT 52 LOT AREA 0.60 AC SITE CLASS. PS DESIGN FLOW 360 L.T.A.R. 0.3

Septic Tank: 1000 Gallons; STB 794 Date 1/29/02

Pump Tank: 1000 Gallons; PT 27 Date 5/5/02

Pump Make: Goulds Model WE0511M Serial No.

Nitrification Field: No Fields 1 Square Feet 400 Linear Feet 200

No Lines 4 @ 50' Trench Width 24" Max Trench Bottom Depth 36" Gravel Depth —

☒ New System ☐ Repair System Type: I. II (III) IV. V. VI

System Description: Press. Man. Panel Block

Repair System Description: Panel Block

Maintenance Agreement Required: ☐ Yes ☒ No

☐ House/Mod. Home No. Bedrooms 3

☒ Mobile Home No. Bathrooms 2

☐ Business No. Employees

☐ Other


☐ Slab ☒ Crawl Space ☐ Basement w/plumbing ☐ Basement wo/plumbing

Water Supply: ☒ Individual ☐ Public ☐ Community

Comments:/Conditions:

Comments:/Conditions:

INITIAL SITE SKETCH 1" = 50'

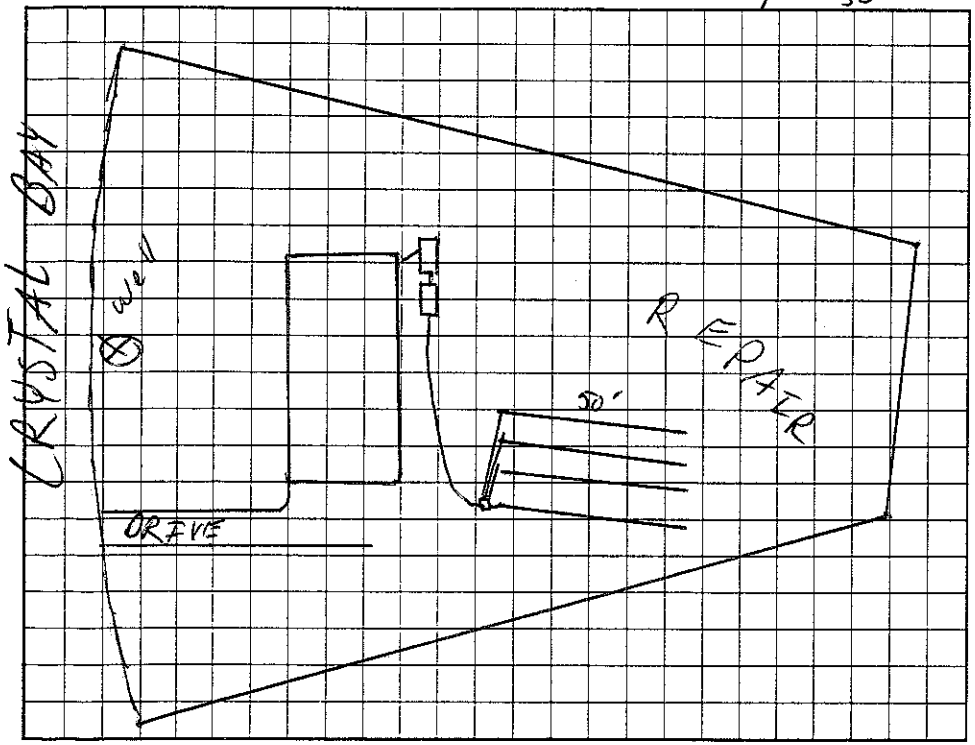

AS BUILT SKETCH

Permit can be suspended or revoked if any false information is supplied toward securing the permit/any unauthorized changes are made to the site/any unauthorized changes are made in the installation of the system. Improvement Permit with plat valid without expiration. Improvement Permit with site plan valid for sixty months. Authorization to Construct is valid for a period equal to that of Improvement Permit – not to exceed sixty months.

Signed: Andy Vander date 4/10 Installed by: Marty Tucker

Improvement Permit by: RS date 5/30/02 Operation Permit by: RS date 8/9/02

Authorization to Construct by: RS date 5/30/02 Existing System Inspection by: date

HEALTH DEPT. COPY: WHITE OWNER COPY (FINAL): YELLOW OWNER COPY (INITIAL): PINK