IREDELL COUNTY HEALTH DEPARTMENT

STATESVILLE 704-878-5305 155.00 Paid MOORESVILLE 704-664-5281

IMPROVEMENT PERMIT / AUTHORIZATION TO CONSTRUCT / OPERATION PERMIT / EXISTING SYSTEM INSPECTION

PERMIT# ~~10042~~ 145762 PIN# 4659-05-7437 DATE 5/23/03

OWNER OR CONTRACTOR Pruitt Dev. Co. LLC / LPD Windward PHONE(S) Business Bryan 400-7019 Home

ADDRESS 142 Stutts Rd Mooresville NC 28117

LOCATION 115 N, TL Sail Winds, TL Crystal Bay on L

SUBDIVISION Windward PT BLOCK / SECTION LOT 195 LOT AREA 0.48Ac SITE CLASS. PS DESIGN FLOW 360 L.T.A.R. 0.3

Septic Tank: 1000 Gallons; STB 786 Date 8/27/07

Pump Tank: 1000 Gallons; PT 32 Date 6/19/07

Pump Make: Zoeller Model N153-B Serial No.

Nitrification Field: No Fields 1 Square Feet 900 Linear Feet 300'

No Lines 4@75' Trench Width 36" Max Trench Bottom Depth 36" Gravel Depth —

☒ New System ☐ Repair System Type: I, II, (III), IV, V, VI

System Description: Press. Man. 25% Red.

Repair System Description: LP Pond Block

Maintenance Agreement Required: ☐ Yes ☒ No

☐ House/Mod. Home ☒ Mobile Home ☐ Business ☐ Other

No. Bedrooms 3 No. Bathrooms 2 No. Employees


Water Supply: ☒ Individual ☐ Public ☐ Community

☐ Slab ☒ Crawl Space ☐ Basement w/plumbing ☐ Basement wo/plumbing

Comments/Conditions: 10/3/07 Reviewed Floor plan & Application, essentially in Compliance with original permit.

Comments/Conditions:

INITIAL SITE SKETCH

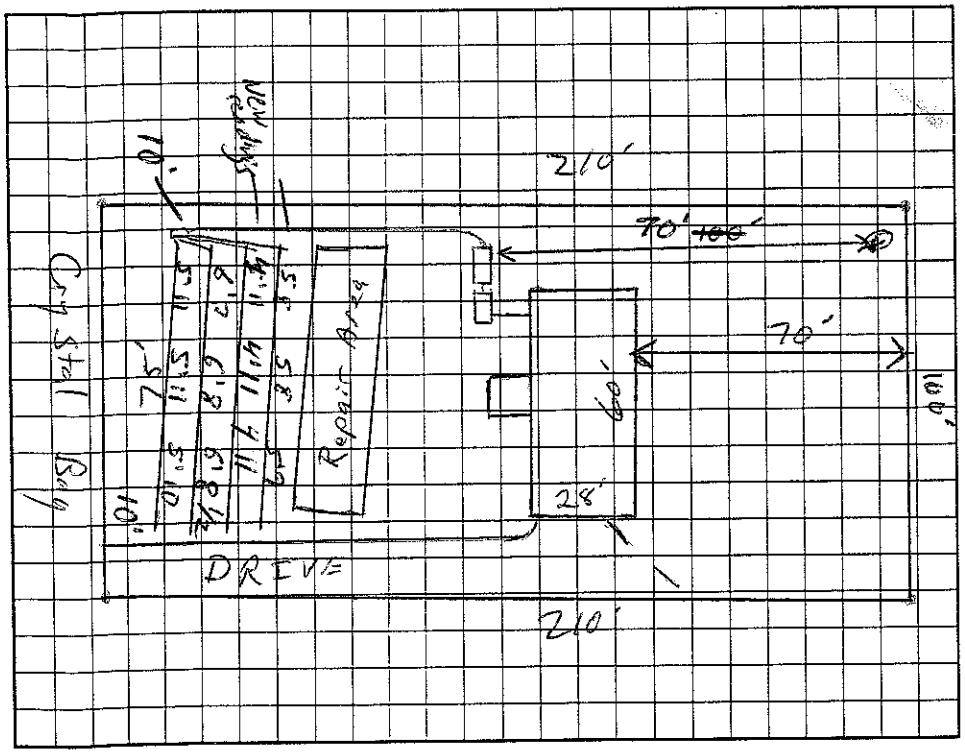

AS BUILT SKETCH

System installed as designed
drainlines & Tanks
Pressure Manifold
Electrical checked 12/5/07

Pressure Tab, Float & alarm 12/6/07

Permit can be suspended or revoked if any false information is supplied toward securing the permit/any unauthorized changes are made to the site/any unauthorized changes are made in the installation of the system. Improvement Permit with plat valid without expiration. Improvement Permit with site plan valid for sixty months. Authorization to Construct is valid for a period equal to that of Improvement Permit – not to exceed sixty months.

Signed: date 6/18/03 Installed by: Buck Grading

Improvement Permit by: RS date 5-23-03 Operation Permit by: Anthony Cokes Jr. date 12/6/07

Authorization to Construct by: date 10/3/07 Existing System Inspection by: date

HEALTH DEPT. COPY: WHITE OWNER COPY (FINAL): YELLOW OWNER COPY (INITIAL): PINK