4:20

IREDELL COUNTY HEALTH DEPARTMENT

STATESVILLE 704-878-5305 MOORESVILLE 704-664-5281

IMPROVEMENT PERMIT / AUTHORIZATION TO CONSTRUCT / OPERATION PERMIT / EXISTING SYSTEM INSPECTION

PERMIT# 94063 PIN# 4659058989 DATE 3/6/01

OWNER OR CONTRACTOR PRUITT DEVELOPMENT PHONE: Business 660-5903 Home

ADDRESS 147 STITTS RD - MOORESVILLE NC 28117

LOCATION 21 N - TL SALISBURY - TL CRYSTAL BAY - ON LT

SUBDIVISION WINWARD PT BLOCK / SECTION 3 LOT 200 LOT AREA .46AC SITE CLASS. PS DESIGN FLOW 480GPD L.T.A.R. .3 gal/ft²

Septic Tank: 1000 Gallons; STB 794 Date 10/17/99
Pump Tank: Gallons; PT Date
Pump Make: Model Serial No.
Nitrification Field: No Fields 1 Square Feet 270 Linear Feet 540
No Lines 6@45' Trench Width 24" Max Trench Bottom Depth 36" Gravel Depth N/A

☑ New System ☐ Repair System Type: I, II, (III), IV, V, VI
System Description: GRAVITY PANEL
Repair System Description: LP PANEL
Maintenance Agreement Required: ☐ Yes ☑ No

☑ House/Mod. Home No. Bedrooms 4
☑ Mobile Home No. Bathrooms 4
☐ Business No. Employees
☐ Other


Water Supply: ☑ Individual ☐ Public ☐ Community

☐ Slab ☑ Crawl Space ☐ Basement w/plumbing ☐ Basement wo/plumbing


Comments:/Conditions:

Comments:/Conditions:

INITIAL SITE SKETCH 1" = 50'

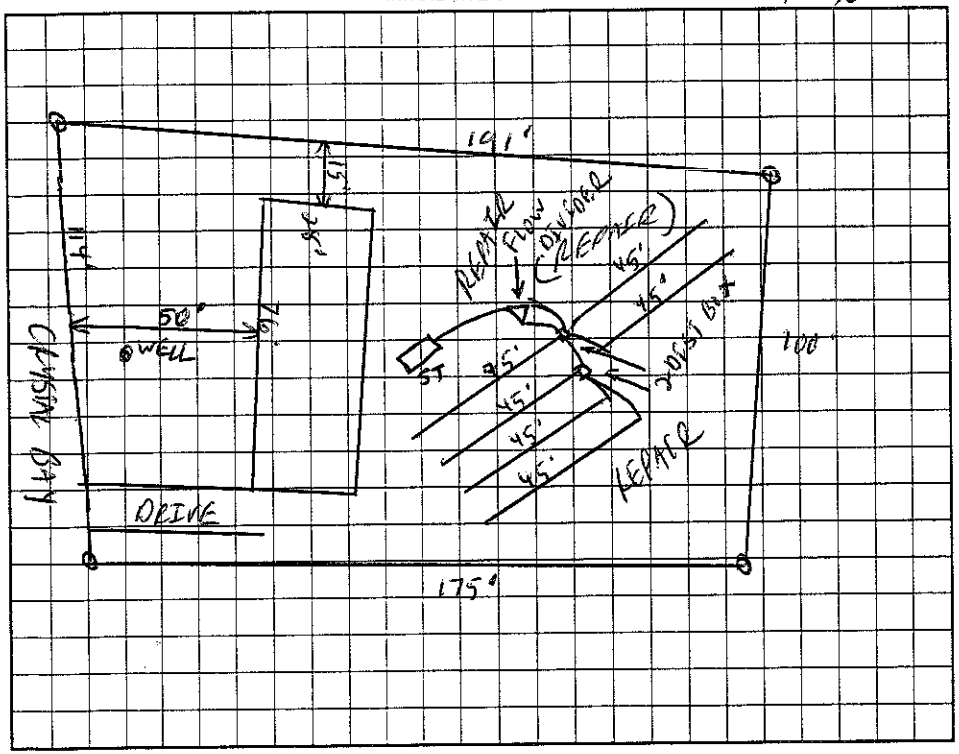

AS BUILT SKETCH

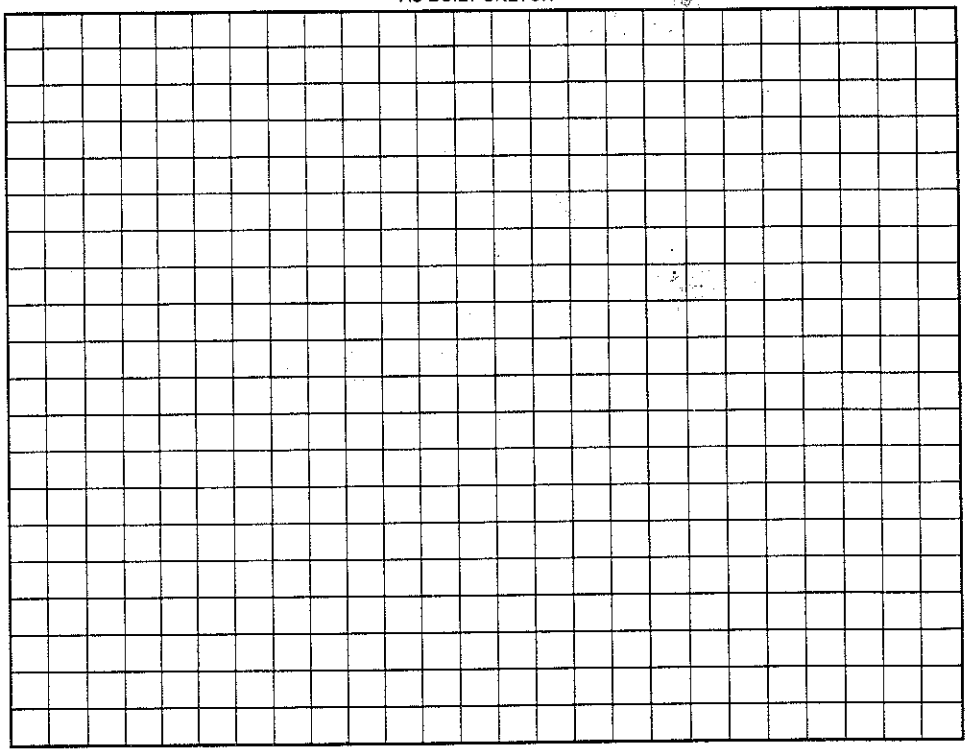

Permit can be suspended or revoked if any false information is supplied toward securing the permit/any unauthorized changes are made to the site/any unauthorized changes are made in the installation of the system. Improvement Permit with plat valid without expiration. Improvement Permit with site plan valid for sixty months. Authorization to Construct is valid for a period equal to that of Improvement Permit – not to exceed sixty months.

Signed: date 3/6/01 Installed by: Craig Thompson

Improvement Permit by: KS date 3/6/01 Operation Permit by: date 4/12/01

Authorization to Construct by: KS date 3/6/01 Existing System Inspection by: date

HEALTH DEPT. COPY: WHITE OWNER COPY (FINAL): YELLOW OWNER COPY (INITIAL): PINK