3:00

IREDELL COUNTY HEALTH DEPARTMENT

Paid 125.00

STATESVILLE 704-878-5305 MOORESVILLE 704-664-5281

IMPROVEMENT PERMIT / AUTHORIZATION TO CONSTRUCT / OPERATION PERMIT / EXISTING SYSTEM INSPECTION

PERMIT# 40992 PIN# 4659068261 PT 4659059808 DATE 12/13/00

OWNER OR CONTRACTOR Pruitt Dev. Co. PHONE: Business 663-6700 Home

ADDRESS 142 Stutts Rd Mooresville NC 28117

LOCATION 115 N, L Sail winds, L Crystal Bay on Lt

SUBDIVISION Windward Pt BLOCK / SECTION 3 LOT 199 LOT AREA 0.47 AC SITE CLASS. PS DESIGN FLOW 360 L.T.A.R. 0.3

Septic Tank: 1000 Gallons; STB 794 Date 1/14/01
Pump Tank: Gallons; PT Date
Pump Make: Model Serial No.
Nitrification Field: No Fields 1 Square Feet 900 Linear Feet 300
No Lines 4 @ 75' Trench Width 36" Max Trench Bottom Depth 36" Gravel Depth —

☒ New System ☐ Repair System Type: I, II, (III), IV, V, VI
System Description: Gravity 25% Reduc.
Repair System Description: PPBS
Maintenance Agreement Required: ☐ Yes ☒ No

☒ House/Mod. Home ☐ Mobile Home ☐ Business ☐ Other
No. Bedrooms 3 No. Bathrooms 2 No. Employees

☐ Slab ☒ Crawl Space ☐ Basement w/plumbing ☐ Basement wo/plumbing


Water Supply: ☒ Individual ☐ Public ☐ Community

Comments:/Conditions:

1:50 Scale

Comments:/Conditions: E-2 Flow Installed

INITIAL SITE SKETCH

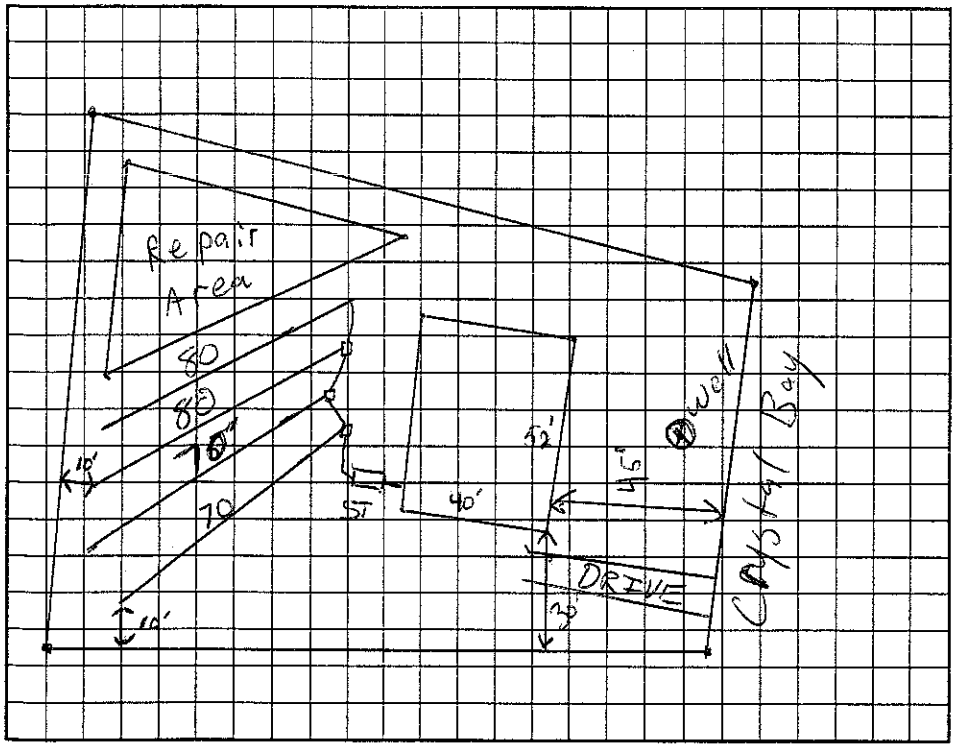

AS BUILT SKETCH

Installed As Drawn

Permit can be suspended or revoked if any false information is supplied toward securing the permit/any unauthorized changes are made to the site/any unauthorized changes are made in the installation of the system. Improvement Permit with plat valid without expiration. Improvement Permit with site plan valid for sixty months. Authorization to Construct is valid for a period equal to that of Improvement Permit – not to exceed sixty months.

Signed: date 12/19/00 Installed by: Craig Thompson

Improvement Permit by: RSI date 12/13/00 Operation Permit by: RS date 5/14/01

Authorization to Construct by: RSI date 12/13/00 Existing System Inspection by: date

HEALTH DEPT. COPY: WHITE OWNER COPY (FINAL): YELLOW OWNER COPY (INITIAL): PINK