4659060881

3:30-9200

...LL COUNTY HEALTH DEPARTMENT Const Auth. STATESVILLE 704-878-5305 MOORESVILLE 704-664-5281

IMPROVEMENT PERMIT / ~~CERTIFICATE OF COMPLETION~~ / OPERATION PERMIT / EXISTING SYSTEM INSPECTION

PROPERTY DESCRIPTION NO. 24869 DATE April 30, '97 TAX MAP NO. part of 4EA12 Watershed: ☑ Yes ☐ No

OWNER OR CONTRACTOR Pruitt Dev. Co PHONE: Business _____ Home _____

ADDRESS 142 Stutts Rd. Mooresville

LOCATION 115-21 N. TL Sailwinds TL Keyside 3rd lot on Right

SUBDIVISION Windward Pt. BLOCK / SECTION _____ LOT 20 LOT AREA 120'x175' SITE CLASS. PS DESIGN FLOW 360gpd L.T.A.R. .13

Septic Tank: 1000 Gallons; STB 794 Date 5/29/97

Pump Tank: _____ Gallons; PT _____ Date _____

Pump Make: _____ Model _____ Serial No. _____

Nitrification Field: No Fields 1 Square Feet 900 Linear Feet 300

No Lines 3@100' Trench Width 36" Max Trench Bottom Depth 24" Gravel Depth NA

☑ New System ☐ Repair System Type: I, II, (III) IV, V, VI

System Description: Gravity Chambered

Repair System Description: 3 Bdrm

Maintenance Agreement Required: ☐ Yes ☑ No

☐ House/Mod. Home No. Bedrooms 3

☑ Mobile Home No. Bathrooms 2

☐ Business No. Employees ____

☐ Other _____


☐ Slab ☑ Crawl Space ☐ Basement w/plumbing ☐ Basement wo/plumbing

Water Supply:
☑ Individual
☐ Community
☐ Public

Comments:

Comments:

INITIAL SITE SKETCH 1"=50'

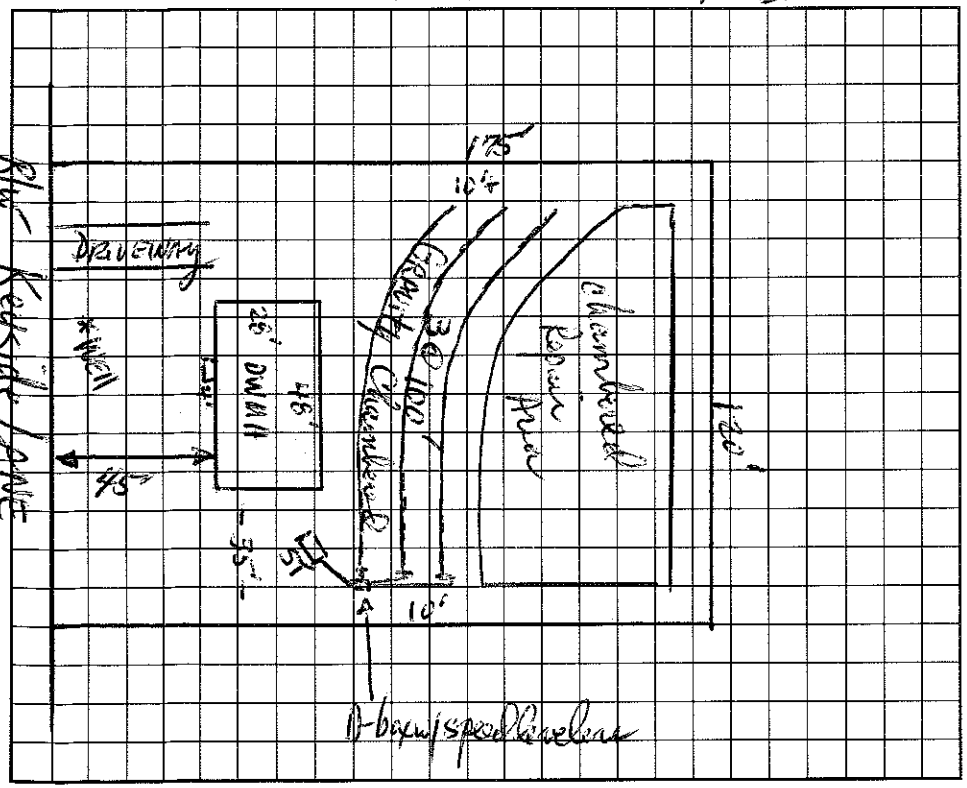

AS BUILT SKETCH

Same as S.E. sketch

I understand that this permit can be suspended or revoked if any false information is supplied toward securing the permit/any unauthorized changes are made to the site/any unauthorized changes are made in the installation of the system. Improvement Permit is valid for 60 months from date of issuance.

Signed: _____

Improvement Permit by: DK Hanson, RS date 4/30/97

Construction ~~Existing System Inspection~~ by: DK Hanson, RS date 4/30/97

Authorization

Installed by: ATLANTIC EXCAVATING

Certificate of Completion by: _____ date _____

Operation Permit by: _____ date 8/25/97

HEALTH DEPT. COPY: WHITE INSPECTION COPY (FINAL): GREEN OWNER COPY (FINAL): YELLOW INSPECTION COPY (INITIAL): PINK OWNER COPY (INITIAL): GOLD