IREDELL COUNTY HEALTH DEPARTMENT

AUTHORIZATION TO CONSTRUCT

STATESVILLE 704-878-5305 MOORESVILLE 704-664-5281

IMPROVEMENT PERMIT / ~~CERTIFICATE OF COMPLETION~~ / OPERATION PERMIT / EXISTING SYSTEM INSPECTION

PROPERTY DESCRIPTION NO. 24868 DATE 6/2/97 TAX MAP NO. 4E A 12 Watershed: ☑ Yes ☐ No

OWNER OR CONTRACTOR PRUITT DEVELOPMENT CO. PHONE: Business ~~4659070044~~ Home 875-5001 4659060963

ADDRESS 290 LAKEVIEW DR. MOORESVILLE NC 28115

LOCATION I-77 N- TL SAILWINDS - TL KEYSIDE 2nd ON RT

SUBDIVISION PRUITT DEV. BLOCK / SECTION 7 LOT 19 LOT AREA 21780 SITE CLASS. PS DESIGN FLOW 360 GPD L.T.A.R. .3600/FT²

Septic Tank: 1000 Gallons; STB ~~1012~~ Date 2/17/98

Pump Tank: _____ Gallons; PT _____ Date _____

Pump Make: _____ Model _____ Serial No. _____

Nitrification Field: No Fields 1 Square Feet 900 Linear Feet 300

No Lines 4 @ 75' Trench Width 36" Max Trench Bottom Depth 24" Gravel Depth N/A

☑ New System ☐ Repair System Type: I, II, (III), IV, V, VI

System Description: GRAVITY CHAMBERED OR SIMILAR

Repair System Description: SAME

Maintenance Agreement Required: ☐ Yes ☑ No

☐ House/Mod. Home No. Bedrooms 3

☑ Mobile Home No. Bathrooms 2

☐ Business No. Employees _____

☐ Other _____


☐ Slab ☑ Crawl Space ☐ Basement w/plumbing ☐ Basement wo/plumbing

Water Supply: ☑ Individual ☐ Community ☐ Public


Comments:

Comments:

INITIAL SITE SKETCH 1"=40'

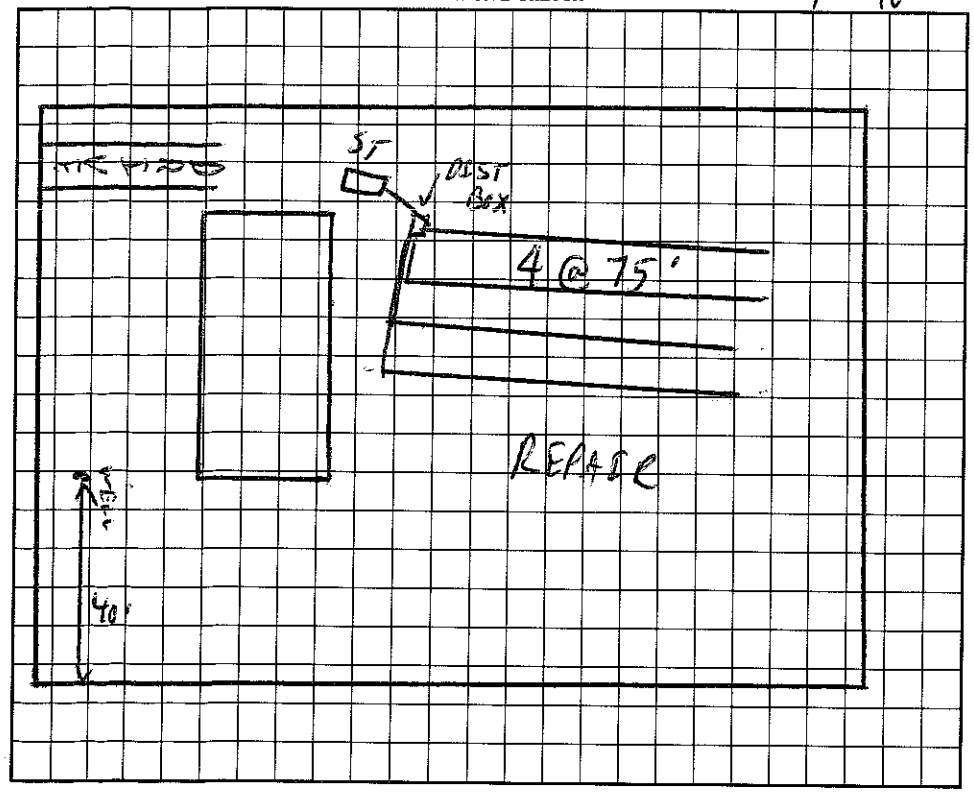

AS BUILT SKETCH

 

I understand that this permit can be suspended or revoked if any false information is supplied toward securing the permit/any unauthorized changes are made to the site/any unauthorized changes are made in the installation of the system. Improvement Permit is valid for 60 months from date of issuance.

Signed: _____

Improvement Permit by: _____ date 6/2/97

~~Existing System Inspection by:~~ AUTHORIZED TO CONSTRUCT _____ date 6/2/97

Installed by: A1 BACKHOE

Certificate of Completion by: _____ date _____

Operation Permit by: _____ date 4/24/98

HEALTH DEPT. COPY: WHITE INSPECTION COPY (FINAL): GREEN OWNER COPY (FINAL): YELLOW INSPECTION COPY (INITIAL): PINK OWNER COPY (INITIAL): GOLD