4659061537 (100)

IREDELL COUNTY HEALTH DEPARTMENT Const. Auth. STATESVILLE 704-878-5305 MOORESVILLE 704-664-5281

IMPROVEMENT PERMIT / ~~CERTIFICATE OF COMPLETION~~ / OPERATION PERMIT / EXISTING SYSTEM INSPECTION

PROPERTY DESCRIPTION NO. 24671 DATE Jan 13, '97 TAX MAP NO. part of 4EA12 Watershed: ☑ Yes ☐ No

OWNER OR CONTRACTOR Pruitt Dev Co. PHONE: Business _____ Home _____

ADDRESS 13420 Reese Blvd W. Huntersville 28078

LOCATION US 115-21 N TL Saltwinds TL Keyside Ln. on Right

SUBDIVISION Windward Pt. BLOCK / SECTION _____ LOT 22 LOT AREA 20,000 ft²+ SITE CLASS. PS DESIGN FLOW 360 gpd L.T.A.R. 1.3

Septic Tank: 1000 Gallons; STB 1012 Date 5/5/97
Pump Tank: _____ Gallons; PT _____ Date _____
Pump Make: _____ Model _____ Serial No. _____
Nitrification Field: No Fields 1 Square Feet 1200 Linear Feet 400
No Lines 4@100' Trench Width 36" Max Trench Bottom Depth ~30" Gravel Depth 12"

☑ New System ☐ Repair System Type: I, II, III, IV, V, VI
System Description: gravity conventional
Repair System Description: Chambered plastic
Maintenance Agreement Required: ☐ Yes ☑ No

☑ House/Mod. Home No. Bedrooms 3
☐ Mobile Home No. Bathrooms 2
☐ Business No. Employees _____
☐ Other _____


☐ Slab ☑ Crawl Space ☐ Basement w/plumbing ☐ Basement wo/plumbing

Water Supply: ☑ Individual ☐ Community ☐ Public


Comments:

Comments: WELL OR MH NOT LOCATED AT TIME OF INSPECTION.

INITIAL SITE SKETCH

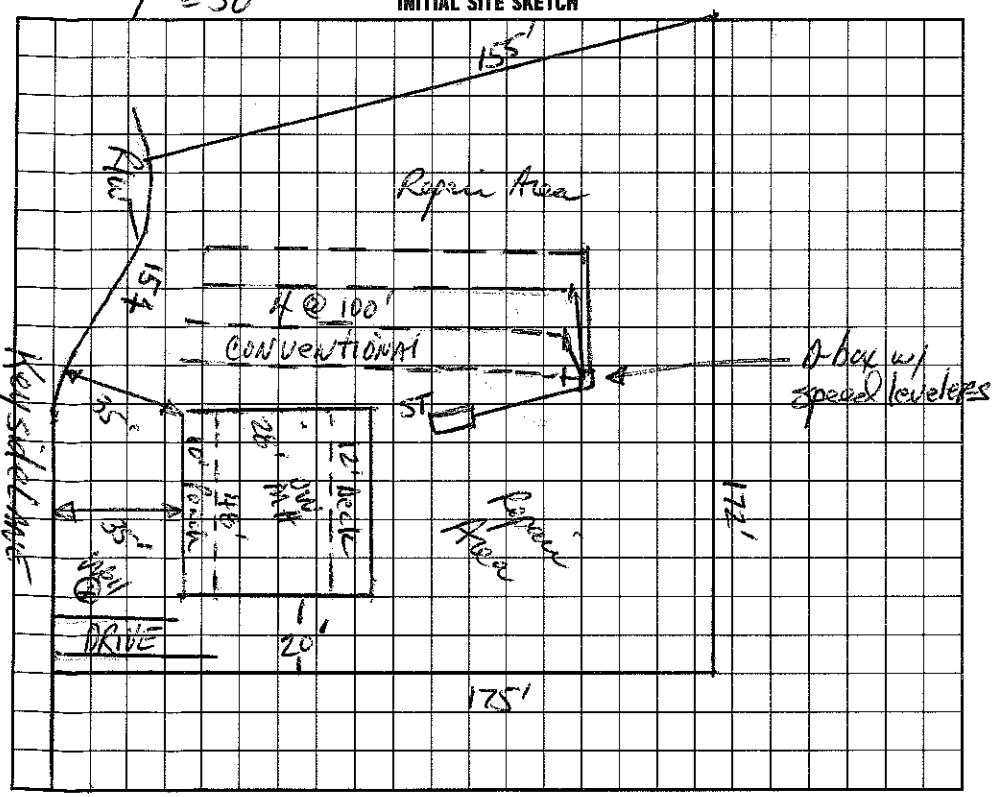

AS BUILT SKETCH

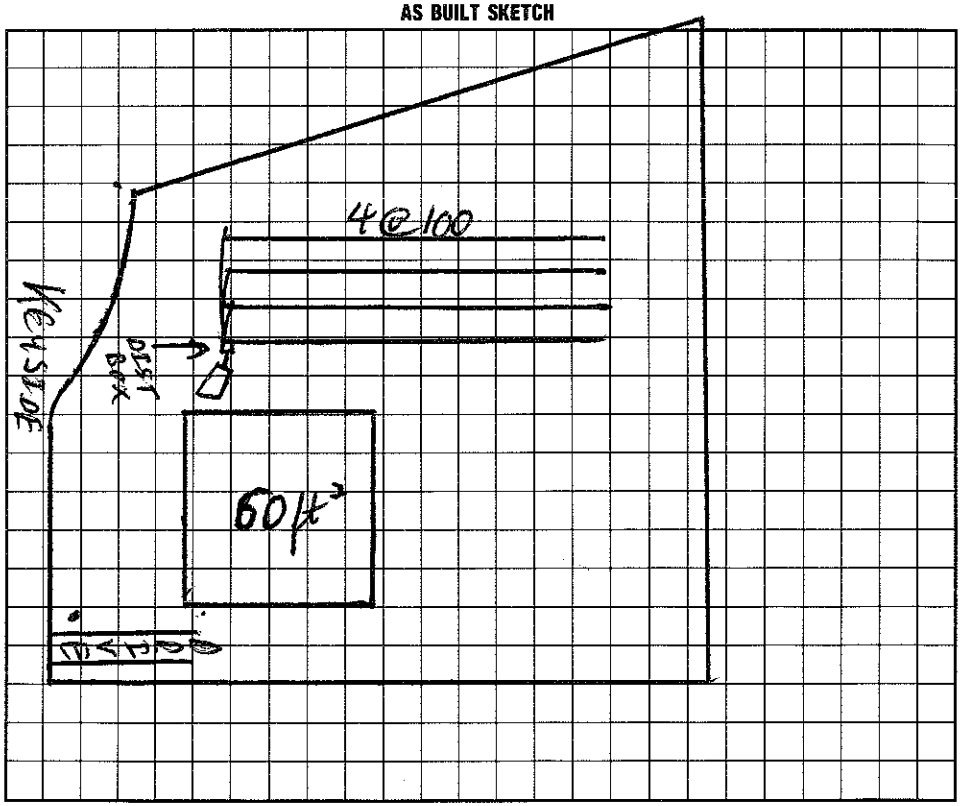

I understand that this permit can be suspended or revoked if any false information is supplied toward securing the permit/any unauthorized changes are made to the site/any unauthorized changes are made in the installation of the system. Improvement Permit is valid for 60 months from ~~date of~~ issuance.

Signed: _____

Improvement Permit by: _____ date 1-13-97

~~Existing System Inspection~~ Construction Authorization by: _____ date 1-13-97

Installed by: A-1 BACKHOE

Certificate of Completion by: _____ date _____

Operation Permit by: _____ date 6/24/97

HEALTH DEPT. COPY: WHITE INSPECTION COPY (FINAL): GREEN OWNER COPY (FINAL): YELLOW INSPECTION COPY (INITIAL): PINK OWNER COPY (INITIAL): GOLD