Auth to Construct 4659062957 3:30 (800)

IREDELL COUNTY HEALTH DEPARTMENT

STATESVILLE 704-878-5305 MOORESVILLE 704-664-5281

IMPROVEMENT PERMIT / ~~CERTIFICATE OF COMPLETION~~ / OPERATION PERMIT / EXISTING SYSTEM INSPECT

PROPERTY DESCRIPTION NO. 24878 DATE 6/2/97 TAX MAP NO. 4E A 12 Watershed: ☒ Yes

OWNER OR CONTRACTOR Pruitt Dev. Co PHONE: Business (800) 722-3633 Home

ADDRESS 142 Stutts Rd

LOCATION US 115/21 N. TL on Sailwards TL on Keyside

SUBDIVISION Windward Pt BLOCK / SECTION LOT 29 LOT AREA 120'x175' SITE CLASS. PS DESIGN FLOW 360gpd L.T.A.R. .3

Septic Tank: 1000 Gallons; STB 1012 Date 11/21/96

Pump Tank: Gallons; PT Date

Pump Make: Model Serial No.

Nitrification Field: No Fields 1 Square Feet 900' Linear Feet 300'

No Lines 4 at 75' Trench Width 3' Max Trench Bottom Depth 36" Gravel Depth N/A

☒ New System ☐ Repair System Type: I, II, III, IV, V, VI

System Description: Gravity - Plastic Chamber

Repair System Description: Gravity - Plastic Chamber

Maintenance Agreement Required: ☐ Yes ☐ No

☒ House/Mod. Home No. Bedrooms 3

☐ Mobile Home No. Bathrooms 2

☐ Business No. Employees

☐ Other

☐ Slab ☒ Crawl Space ☐ Basement w/plumbing ☐ Basement wo/plumbing


Water Supply: ☒ Individual ☐ Community ☐ Public

Comments: * Install inspection ports near end of each line

Comments:

INITIAL SITE SKETCH

1:50

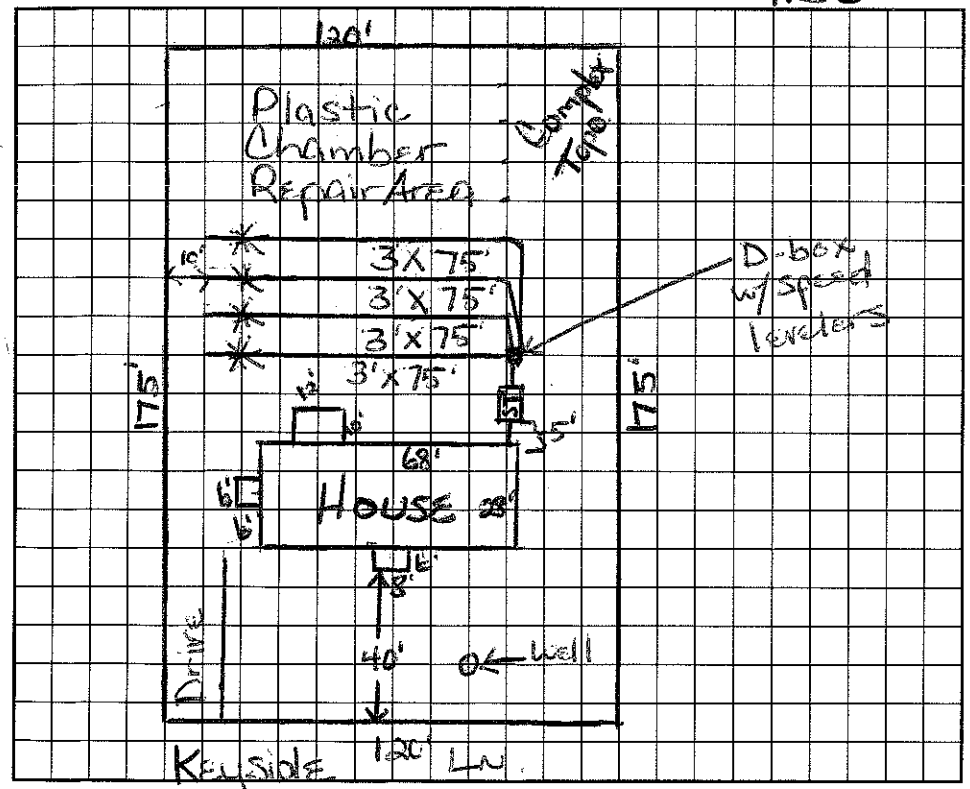

AS BUILT SKETCH

I understand that this permit can be suspended or revoked if any false information is supplied toward securing the permit/any unauthorized changes are made to the site/any unauthorized changes are made in the installation of the system. Improvement Permit is valid for 60 months from date of issuance.

Signed: GT

Improvement Permit by: Main HH Dotson date 6/2/97

~~Existing System~~ Inspection by: Main HH Dotson date 6/2/97

Installed by: A1 BACKHOE

Certificate of Completion by: date

Operation Permit by: C. [illegible] date 3/13/98

Auth to Construct HEALTH DEPT. COPY: WHITE INSPECTION COPY (FINAL): GREEN OWNER COPY (FINAL): YELLOW INSPECTION COPY (INITIAL): PINK OWNER COPY (INITIAL): GOLD