4659043631

IREDELL COUNTY HEALTH DEPARTMENT

STATESVILLE 704-878-5305 MOORESVILLE 704-664-5281

IMPROVEMENT PERMIT / CERTIFICATE OF COMPLETION / OPERATION PERMIT / EXISTING SYSTEM INSPECTIC

PROPERTY DESCRIPTION NO. 24875 DATE 2-6-97 TAX MAP NO. 4EA 12 Watershed: ☑ Yes ☐ No

OWNER OR CONTRACTOR Pruitt Development Co. PHONE: Business 875 8001 Home WSIV-CA

ADDRESS 290 Lakeview Dr. Mooresville

LOCATION US 21 Turn Sailwinds TL Keysite 5th lot left

SUBDIVISION Windward Pt. BLOCK / SECTION LOT 26 LOT AREA 1.5? acres SITE CLASS. PS DESIGN FLOW 360 L.T.A.R. .3

Septic Tank: 1000 Gallons; STB 1012 Date 2/17/96

Pump Tank: Gallons; PT Date

Pump Make: Model Serial No.

Nitrification Field: No Fields 1 Square Feet 400 Linear Feet 200

No Lines 3 Trench Width 24" Max Trench Bottom Depth 36" Gravel Depth N/A

☑ New System ☐ Repair System Type: I, II, III, IV, V, VI

System Description: Gravity Panel I II

Repair System Description:

Maintenance Agreement Required: ☐ Yes ☑ No

☐ House/Mod. Home No. Bedrooms 3

☐ Mobile Home No. Bathrooms 2

☐ Business No. Employees

☐ Other


☐ Slab ☑ Crawl Space ☐ Basement w/plumbing ☐ Basement wo/plumbing

Water Supply: ☐ Individual ☐ Community ☐ Public

Comments: 3" PVC sch 40 reduce to 2" out of Dist box with speed levers

Comments:

INITIAL SITE SKETCH

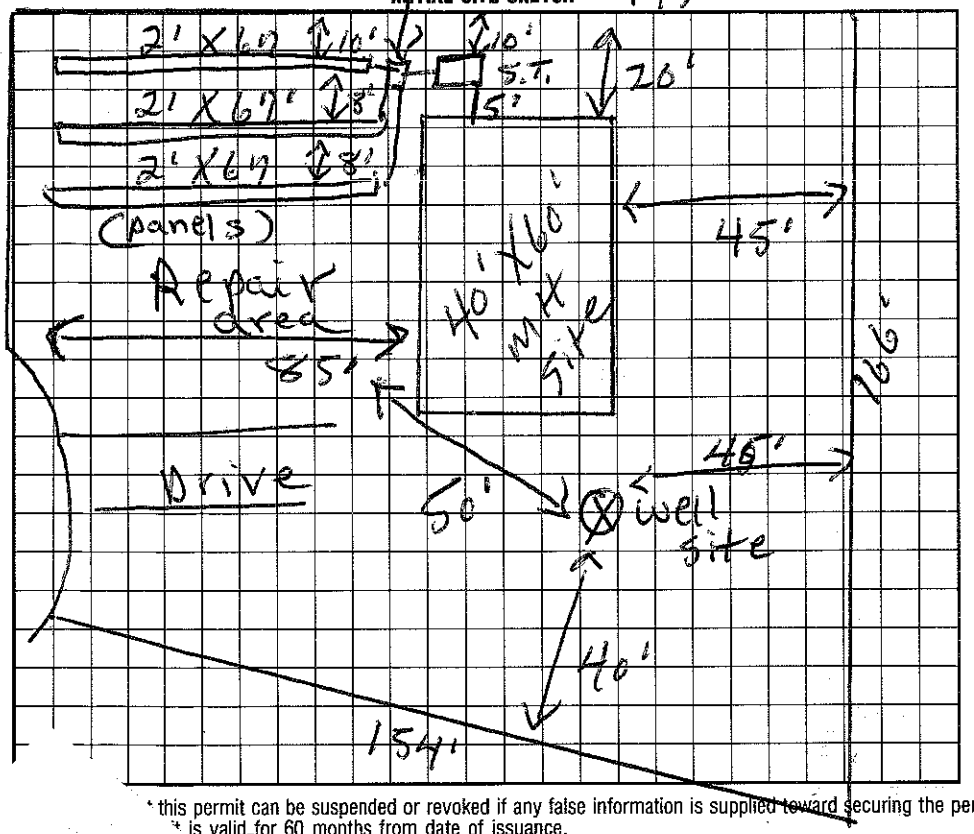

AS BUILT SKETCH

* this permit can be suspended or revoked if any false information is supplied toward securing the permit/any unauthorized changes are made to the site/any unauthorized changes are made in the installation of the system.

* is valid for 60 months from date of issuance.

E. C. Moore date 2-6-97

E. C. Moore date 2-6-97

Installed by: Al Backhoe

Certificate of Completion by: date

Operation Permit by: C. [illegible] date 4/24/98

INSPECTION COPY (FINAL): GREEN OWNER COPY (FINAL): YELLOW INSPECTION COPY (INITIAL): PINK OWNER COPY (INITIAL): GOLD