4659063709

IREDELL COUNTY HEALTH DEPARTMENT

Const. Auth. STATESVILLE 704-878-5305 MOORESVILLE 704-664-5281

IMPROVEMENT PERMIT / ~~CERTIFICATE OF COMPLETION~~ / OPERATION PERMIT / EXISTING SYSTEM INSPECTIO

PROPERTY DESCRIPTION NO 24876 DATE Jan 13, '97 TAX MAP NO. part of 4EA12 Watershed: ☑ Yes ☐ N

OWNER OR CONTRACTOR Truitt Dev Co. PHONE: Business _____ Home _____

ADDRESS 13420 Reese Blvd W. Huntersville 28078

LOCATION 21 N. TL Sailwinds TL Keyside Ln on left

SUBDIVISION Windward Pt BLOCK / SECTION _____ LOT 27 LOT AREA 120'x175' SITE CLASS. Spr. 1996 DESIGN FLOW 360gpd L.T.A.R. .3

Septic Tank: 1000 Gallons; STB 794 Date 1/16/97

Pump Tank: _____ Gallons; PT _____ Date _____

Pump Make: _____ Model _____ Serial No. _____

Nitrification Field: No Fields 1 Square Feet 900 Linear Feet 300

No Lines 4@75' Trench Width 36" Max Trench Bottom Depth ~30" Gravel Depth NA

☑ New System ☐ Repair System Type: I, II, (III), IV, V, VI

System Description: gravity plastic chambered

Repair System Description: gravity pumped panel b/lk

Maintenance Agreement Required: ☐ Yes ☐ No

☐ Slab ☑ Crawl Space ☐ Basement w/plumbing ☐ Basement wo/plumbing

☐ House/Mod. Home No. Bedrooms 3

☑ Mobile Home No. Bathrooms 2

☐ Business No. Employees _____


☐ Other _____

Water Supply:
☑ Individual
☐ Community
☐ Public

Comments: 83
77
84
86

Comments: MOBILE HOME AND WELL NOT LOCATED AT TIME OF INSPECTION.

INITIAL SITE SKETCH

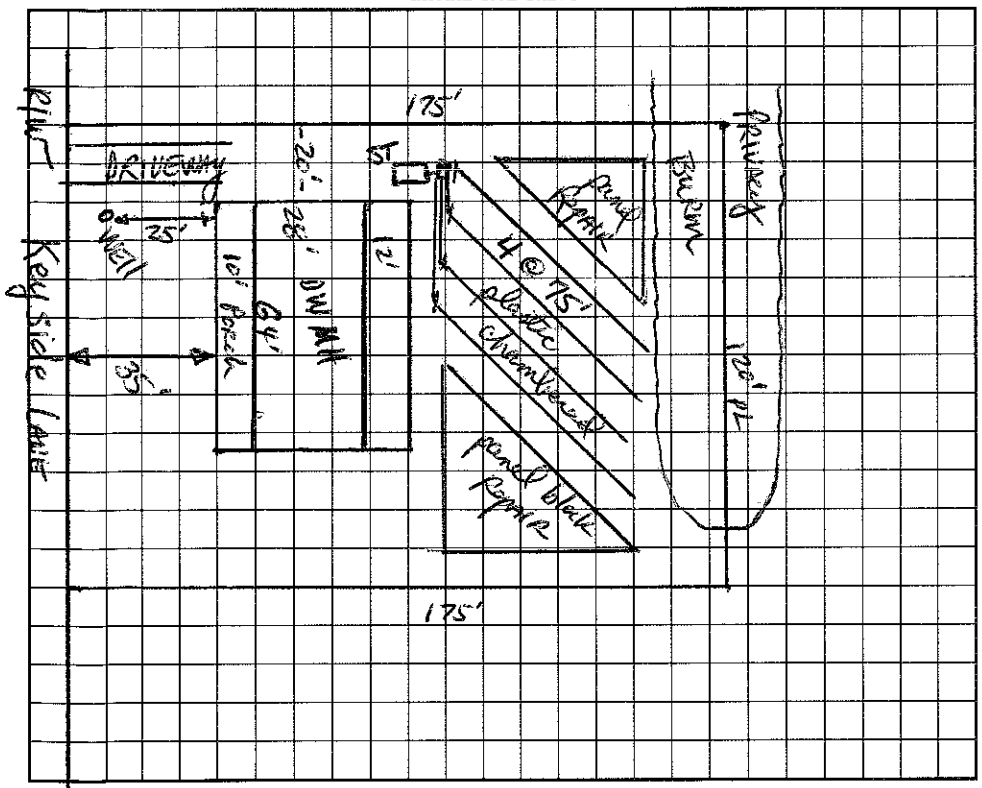

AS BUILT SKETCH

SAME AS SITE SKETCH.

I understand that this permit can be suspended or revoked if any false information is supplied toward securing the permit/any unauthorized changes are made to the site/any unauthorized changes are made in the installation of the system. Improvement Permit is valid for 60 months from date of issuance.

Signed: _____

Improvement Permit by: _____ date 1-13-97

~~Existing System Inspection by~~: _____ date 1-13-97

Installed by: TIM AMMONS

Certificate of Completion by: _____ date _____

Operation Permit by: _____ date 3/24/97

HEALTH DEPT. COPY: WHITE INSPECTION COPY (FINAL): GREEN OWNER COPY (FINAL): YELLOW INSPECTION COPY (INITIAL): PINK OWNER COPY (INITIAL): GOLD