COUNTY HEALTH DEPARTMENT — Auth to construction

4659065717

STATESVILLE 704-878-5305 MOORESVILLE 704-664-5281

3rd

IMPROVEMENT PERMIT / CERTIFICATE OF COMPLETION / OPERATION PERMIT / EXISTING SYSTEM INSPECTION

PROPERTY DESCRIPTION NO. 24883 DATE 6/23/97 TAX MAP NO. 4E A12 Watershed: ☒ Yes ☐ No

OWNER OR CONTRACTOR Pruitt Dev Co. PHONE: Business _____ Home _____

ADDRESS 142 Stutts Rd Mooresville, NC

LOCATION 21 N to Sailwinds Tl Crystal Bay Dr TL

SUBDIVISION Windward Pt BLOCK / SECTION _____ LOT 34 LOT AREA 21780 sq ft SITE CLASS. PS DESIGN FLOW 360 gpd L.T.A.R. .25 - .3

Septic Tank: _____ Gallons; STB 1101 Date 7/4/97

Pump Tank: _____ Gallons; PT _____ Date _____

Pump Make: _____ Model _____ Serial No. _____

Nitrification Field: No Fields 1 Square Feet 1080 Linear Feet 360

No Lines 6 at 60' Trench Width 36" Max Trench Bottom Depth 36 Gravel Depth N/A

☒ New System ☐ Repair System Type: I, II, III, IV, V, VI

System Description: Gravity - Plastic Chamber

Repair System Description: Paved Blk

Maintenance Agreement Required: ☒ Yes ☐ No

☒ House/Mod. Home No. Bedrooms 3

☐ Mobile Home No. Bathrooms _____

☐ Business No. Employees _____

☐ Other _____


☐ Slab ☒ Crawl Space ☐ Basement w/plumbing ☐ Basement wo/plumbing

Water Supply: ☒ Individual ☐ Community ☐ Public

Comments: ☒ Install inspection ports near end of each lateral.

Comments: HOUSE AND WELL NOT LOCATED AT TIME OF INSPECTION.

INITIAL SITE SKETCH Scale 1.50

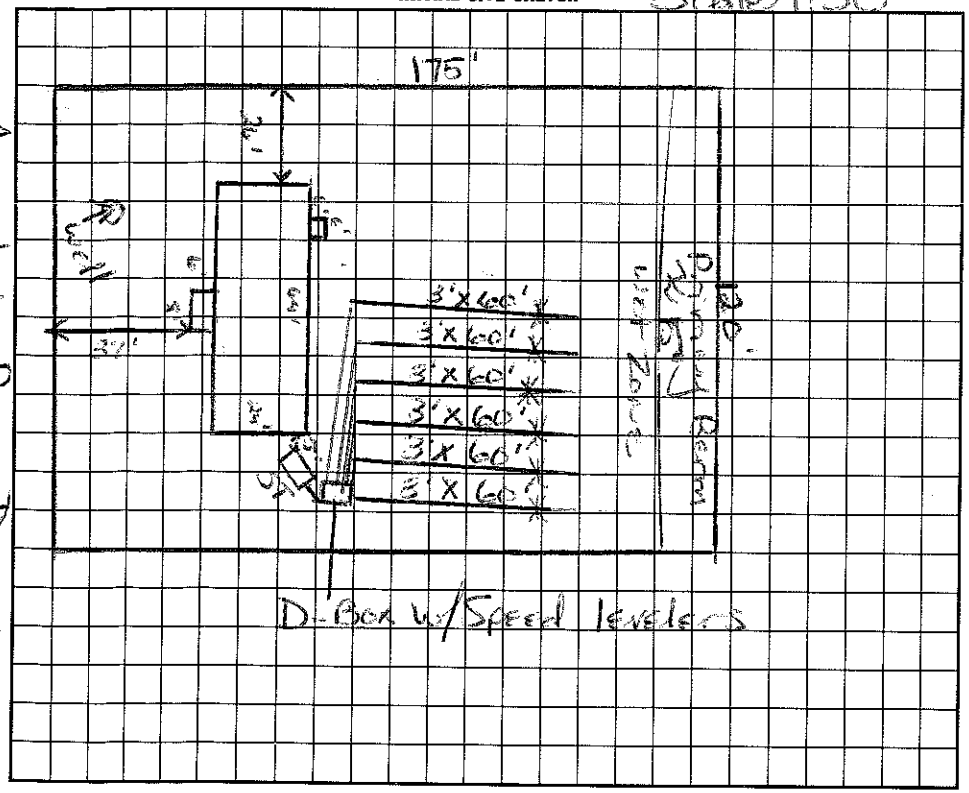

AS BUILT SKETCH

Same as site sketch

I understand that this permit can be suspended or revoked if any false information is supplied toward securing the permit/any unauthorized changes are made to the site/any unauthorized changes are made in the installation of the system. Improvement Permit is valid for 60 months from date of issuance.

Signed: _____

Improvement Permit by: Maria H. Dotson date 6/24/97

Existing System Inspection by: Maria H. Dotson date 6/24/97

Installed by: A1 Backhoe

Certificate of Completion by: _____ date _____

Operation Permit by: C. _____ date 9/16/97

Auth to construct

HEALTH DEPT. COPY: WHITE INSPECTION COPY (FINAL): GREEN OWNER COPY (FINAL): YELLOW INSPECTION COPY (INITIAL): PINK OWNER COPY (INITIAL): GOLD