IREDELL C...TY HEALTH DEPARTMENT

STATESVILLE 704-878-5305 MOORESVILLE 704-664-5281

IMPROVEMENT PERMIT / AUTHORIZATION TO CONSTRUCT / OPERATION PERMIT / EXISTING SYSTEM INSPECTION

+250 11:30

PERMIT# 11137 PIN# 4659-06-6310 DATE 3-3-08

OWNER OR APPLICANT Full Spectrum PHONE: Business 828 3127746 Home

ADDRESS P.O. Box 1049 Troutman, NC 28166

LOCATION Hwy 115 N Tr Sailwinds Tr Crystal Bay on Corner with Clear Springs

SUBDIVISION Windward Pt BLOCK / SECTION 3 LOT 142 LOT AREA .74 Acre SITE CLASS PS DESIGN FLOW 360gpd L.T.A.R. .3

Septic Tank: 1000 Gallons: STB 1866 Date 11-12-07

Pump Tank: 1000 Gallons: PT 32 Date 10-19-07

Pump Make: Zoeller Model Serial No.

Nitrification Field: No Fields 1 Square Feet 600' Linear Feet 200'

No Lines 4@50' Trench Width 24" min Max Trench Bottom Depth 36" Gravel Depth N/A ☐ Gravity ☒ Pressure

☒ New System ☐ Repair ☐ Expansion System Type: I II ☒ III IV V VI

System Description: Pump-PM-Panel Blk

Repair System Description: LP-Panel Blk

Maintenance Agreement Required: ☐ Yes ☒ No Not Initially

☒ House/Mod. Home ☐ Mobile Home ☐ Business ☐ Other

No. Bedrooms 3 No. Persons No. Employees


Water Supply: ☒ Individual ☐ Public ☐ Community

☐ Slab ☒ Crawl Space ☐ Basement w/plumbing ☐ Basement wo/plumbing

Comments:/Conditions: Note: Per 15A NCAC 18A .1720 well must be 50ft from surface water body. ☆ Keep Supply line 10ft from PL.

Comments:/Conditions: PM = Pressure Manifold
8/1/08 Tanks inspected
8/18/08 Checked lines
9/21/08 Checked pressure 2ft, elect. alarm

INITIAL SITE SKETCH Scale 1:50

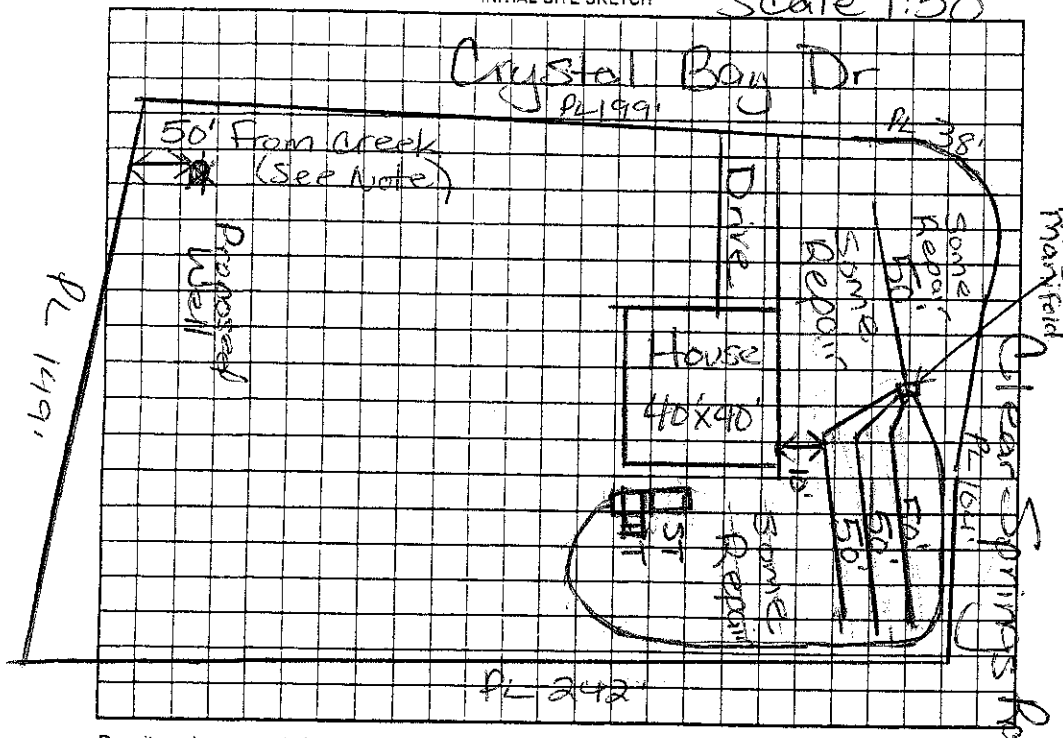

AS BUILT SKETCH

Dug out around NEMA 4X Box
Soil 12" above grade.

Permit can be suspended or revoked if any false information is supplied toward securing the permit/any unauthorized changes are made to the site/any unauthorized changes are made in the installation of the system. Improvement Permit with plat valid without expiration ☐ Improvement Permit with site plan valid for sixty months ☐ Authorization to Construct is valid for a period equal to that of Improvement Permit – not to exceed sixty months.

Signed: [signature] date

Improvement Permit by: Maintained Tolson RS date 3/3/08


Authorization to Construct by: Maintained Tolson RS date 3/3/08

Installed by: Buck's Grading

Operation Permit by: Maintained Tolson RS date 9/21/08

Existing System Inspection by: date

HEALTH DEPT. COPY: WHITE OWNER COPY (FINAL): YELLOW OWNER COPY (INITIAL): PINK

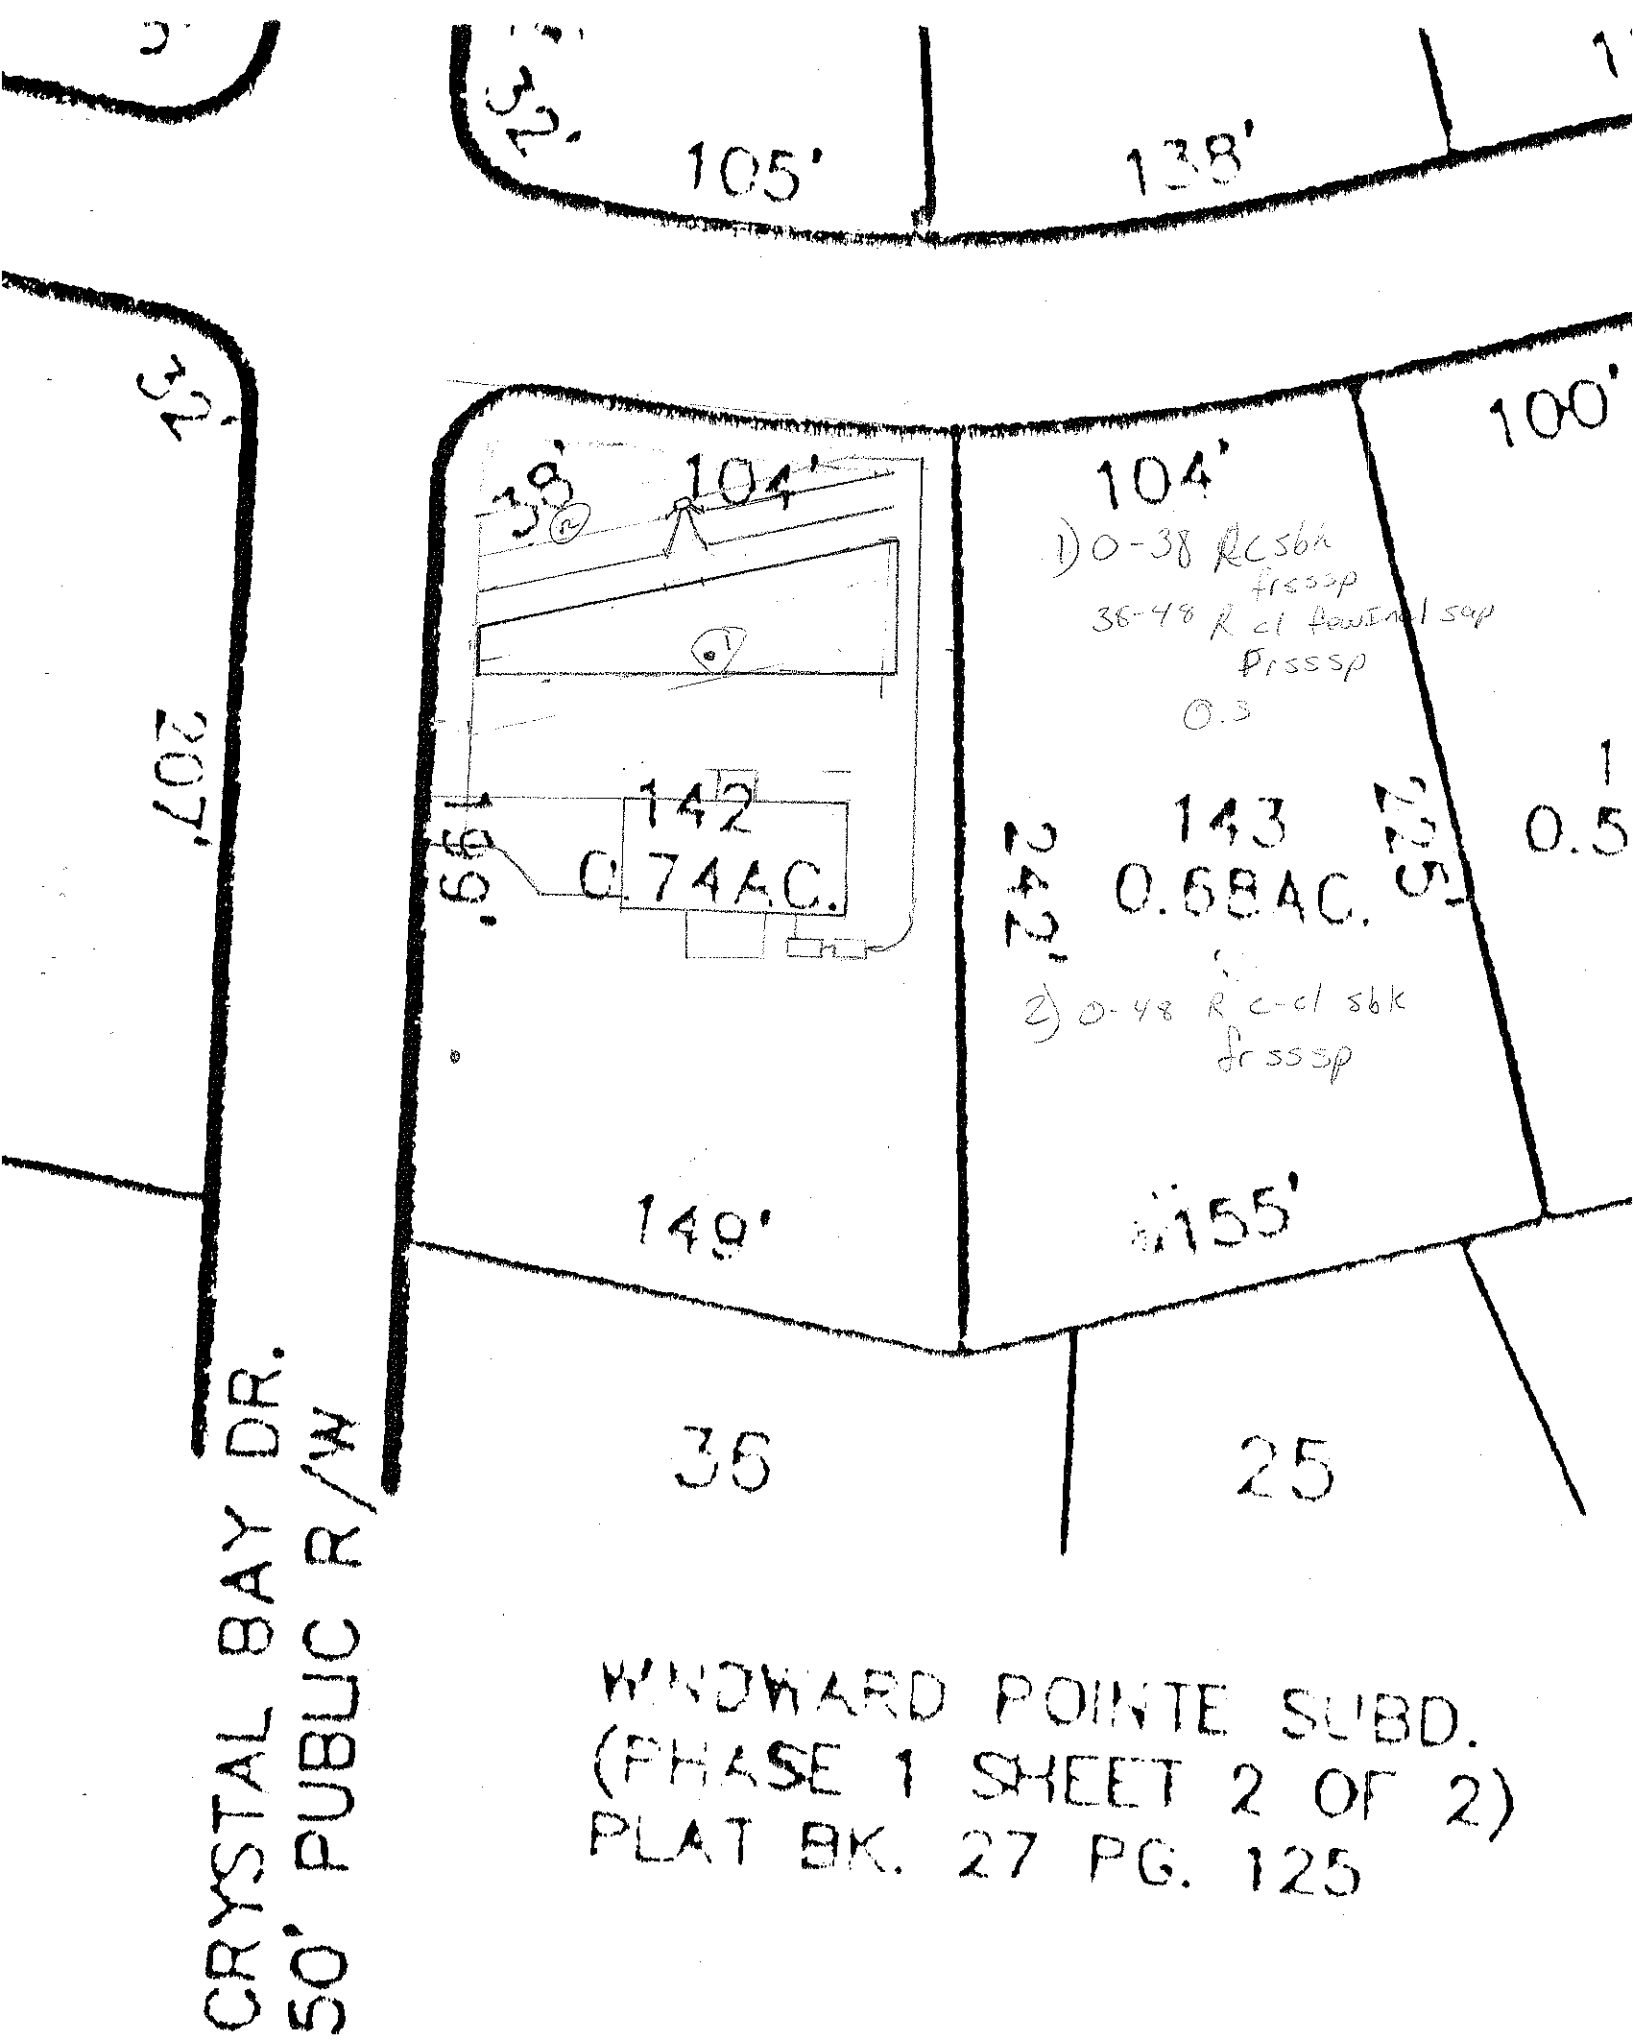

WINDWARD POINTE SUBD.
(PHASE 1 SHEET 2 OF 2)
PLAT BK. 27 PG. 125