4659066891

IREDELL COUNTY HEALTH DEPARTMENT Court Addy. STATESVILLE 704-878-5305 MOORESVILLE 704-664-5281

IMPROVEMENT PERMIT / ~~CERTIFICATE OF COMPLETION~~ / OPERATION PERMIT / EXISTING SYSTEM INSPECTION

PROPERTY DESCRIPTION NO. 24888 DATE April 30, 197 TAX MAP NO. part of 46412 Watershed: ☑ Yes ☐ No

OWNER OR CONTRACTOR Pruitt Dev. Co. PHONE: Business _____ Home _____

ADDRESS 142 Stella Rd, Mooresville

LOCATION 115-21 N. TL Sailwinds TL Crystal Bay 4th on left

SUBDIVISION Windward Pt. BLOCK / SECTION _____ LOT 39 LOT AREA 120'X175' SITE CLASS. RS DESIGN FLOW 360gpd L.T.A.R. .3

Septic Tank: 1000 Gallons; STB 1012 Date 3/3/97
Pump Tank: _____ Gallons; PT _____ Date _____
Pump Make: _____ Model _____ Serial No. _____
Nitrification Field: No Fields 1 Square Feet 1200 Linear Feet 400
No Lines 5@80' Trench Width 36" Max Trench Bottom Depth 36" Gravel Depth 12"

☑ New System ☐ Repair System Type: I, II, III, IV, V, VI
System Description: gravity conventional
Repair System Description: gravity chambered
Maintenance Agreement Required: ☐ Yes ☑ No


☐ House/Mod. Home No. Bedrooms 3
☑ Mobile Home No. Bathrooms 2
☐ Business No. Employees ____
☐ Other _____
☐ Slab ☑ Crawl Space ☐ Basement w/plumbing ☐ Basement wo/plumbing

Water Supply:
☑ Individual
☐ Community
☐ Public

Comments:

Comments:

INITIAL SITE SKETCH 1"=50'

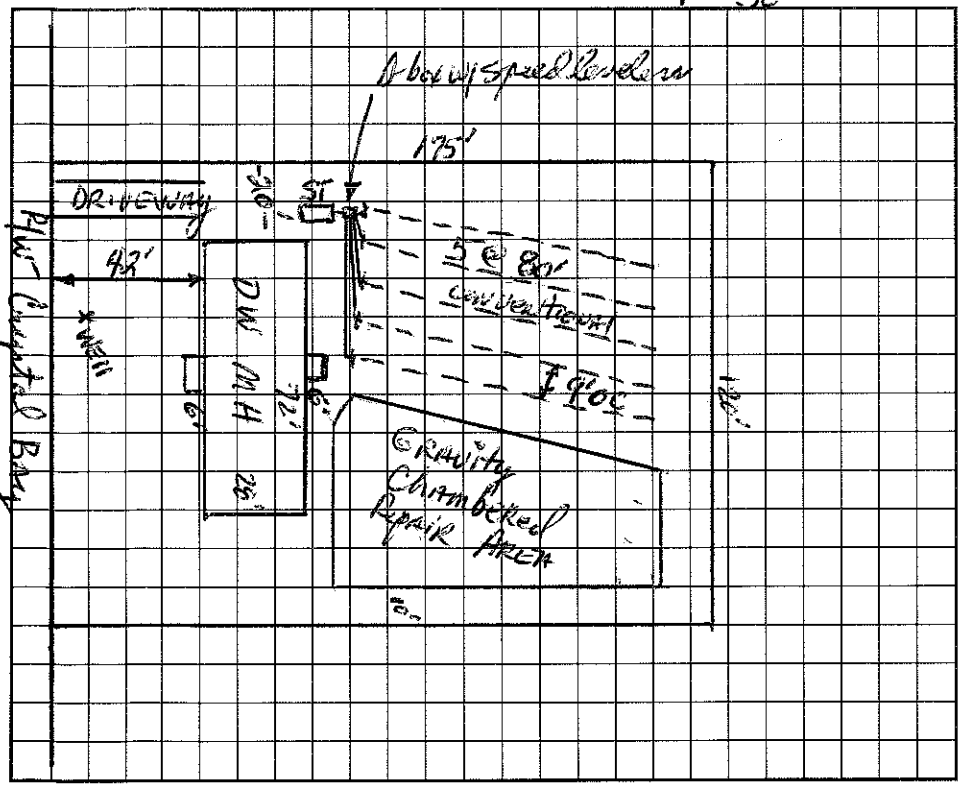

AS BUILT SKETCH

I understand that this permit can be suspended or revoked if any false information is supplied toward securing the permit/any unauthorized changes are made to the site/any unauthorized changes are made in the installation of the system. Improvement Permit is valid for 60 months from date of issuance.

Signed: _____

Improvement Permit by: _____ date 4/30/97

~~Construction~~ ~~Existing System Inspection~~ by: _____ date 4/30/97

Authorization

Installed by: Dennis Gilbert

Certificate of Completion by: Wesley Sparks RS date 5/6/97

Operation Permit by: Wesley Sparks RS date 5/6/97

HEALTH DEPT. COPY: WHITE INSPECTION COPY (FINAL): GREEN OWNER COPY (FINAL): YELLOW INSPECTION COPY (INITIAL): PINK OWNER COPY (INITIAL): GOLD