4659066973 3:30pm

Auth. to Construct

IREDELL COUNTY HEALTH DEPARTMENT

STATESVILLE 704-878-5305 MOORESVILLE 704-664-5281

IMPROVEMENT PERMIT / CERTIFICATE OF COMPLETION / OPERATION PERMIT / ~~EXISTING SYSTEM INSPECTION~~

PROPERTY DESCRIPTION NO. 24889 DATE 5/8/97 TAX MAP NO. 4E-A-12 Watershed: ☒ Yes ☐ No

OWNER OR CONTRACTOR Pruitt Development PHONE: Business 660-5900 Home 875-0081 WSIIBCA

ADDRESS 142 Stutts Rd. Mooresville NC 28115

LOCATION 115 N. to Windward Pt. TL Sailwinds TL Crystal Bay Dr. 3rd Lot on left

SUBDIVISION Windward Pt. BLOCK / SECTION ____ LOT 40 LOT AREA .48 Acre SITE CLASS. PS. DESIGN FLOW 360 gpd L.T.A.R. .3

Septic Tank: 1000 Gallons; STB 821 Date 5/4/97

Pump Tank: ____ Gallons; PT ____ Date ____

Pump Make: ____ Model ____ Serial No. ____

Nitrification Field: No Fields 1 Square Feet 900' Linear Feet 300'

No Lines 4 Trench Width 3' Max Trench Bottom Depth ____ Gravel Depth N/A

☒ New System ☐ Repair System Type: I, II, (III), IV, V, VI

System Description: Gravity to Plastic Chamber

Repair System Description: Modified - Plastic Chamber

Maintenance Agreement Required: ☐ Yes ☒ No

☐ House/Mod. Home ☒ Mobile Home ☐ Business ☐ Other ____

No. Bedrooms 3 No. Bathrooms 2 No. Employees ____


☐ Slab ☒ Crawl Space ☐ Basement w/plumbing ☐ Basement wo/plumbing

Water Supply: ☒ Individual ☐ Community ☐ Public

Comments:

Comments:

INITIAL SITE SKETCH Scale = 1:50'

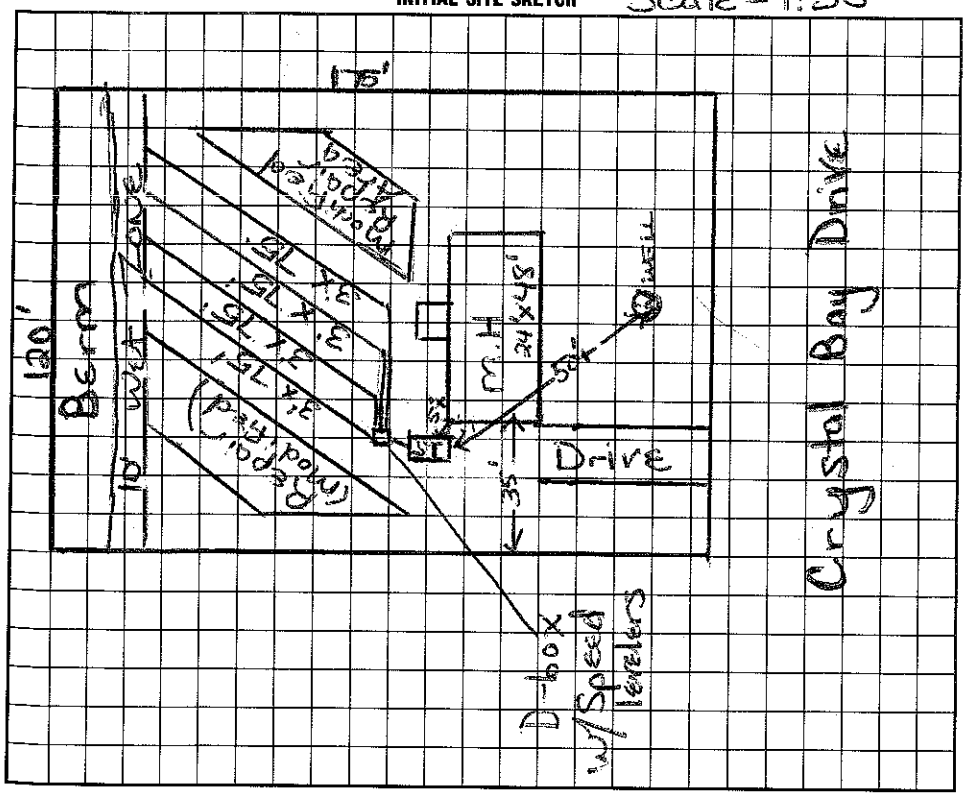

AS BUILT SKETCH

I understand that this permit can be suspended or revoked if any false information is supplied toward securing the permit/any unauthorized changes are made to the site/any unauthorized changes are made in the installation of the system. Improvement Permit is valid for 60 months from date of issuance.

Signed: ____

Improvement Permit by: Maria H. H. Dotson date 5/8/97

~~Existing System~~ Inspection by: Maria H. H. Dotson date 5/8/97

Installed by: D + M Enterprises

Certificate of Completion by: Wesley Sparks R.S. date 6/1/97

Operation Permit by: Wesley Sparks R.S.

Auth. to Construct

HEALTH DEPT. COPY: WHITE INSPECTION COPY (FINAL): GREEN OWNER COPY (FINAL): YELLOW INSPECTION COPY (INITIAL): PINK OWNER