IREDELL COUNTY HEALTH DEPARTMENT

STATESVILLE 704-878-5305 MOORESVILLE 704-664-5281

IMPROVEMENT PERMIT / AUTHORIZATION TO CONSTRUCT / OPERATION PERMIT / EXISTING SYSTEM INSPECTION

DATE 3/6/01

PERMIT# 94066 PIN# 4659068170

OWNER OR CONTRACTOR PRUITT DEV. PHONE: Business _____ Home _____

ADDRESS 142 STUTTS RD MOORESVILLE

LOCATION 21N- TL SAZ WENDOS -TL CRYSTAL BAY - ON LT

SUBDIVISION WINWARD PT BLOCK / SECTION 3 LOT 201 LOT AREA .5 AC SITE CLASS. PS DESIGN FLOW 360GPD L.T.A.R. .3650/102

Septic Tank: 1000 Gallons; STB 1017 Date 1/11/62

Pump Tank: _____ Gallons; PT _____ Date _____

Pump Make: _____ Model _____ Serial No. _____

Nitrification Field: No Fields 1 Square Feet 400 Linear Feet 300

No Lines 4@75' Trench Width 36" Max Trench Bottom Depth 36" Gravel Depth N/A

☑ New System ☐ Repair System Type: I, II, (III) IV, V, VI

System Description: GRAVITY 25% REDUCTION

Repair System Description: SAME

Maintenance Agreement Required: ☐ Yes ☑ No

☑ House/Mod. Home No. Bedrooms 3

☐ Mobile Home No. Bathrooms 3

☐ Business No. Employees _____

☐ Other _____


☐ Slab ☑ Crawl Space ☐ Basement w/plumbing ☐ Basement wo/plumbing

Water Supply: ☑ Individual ☐ Public ☐ Community

Comments:/Conditions:

Comments:/Conditions: Ch. Plastic installed

INITIAL SITE SKETCH 1" = 50'

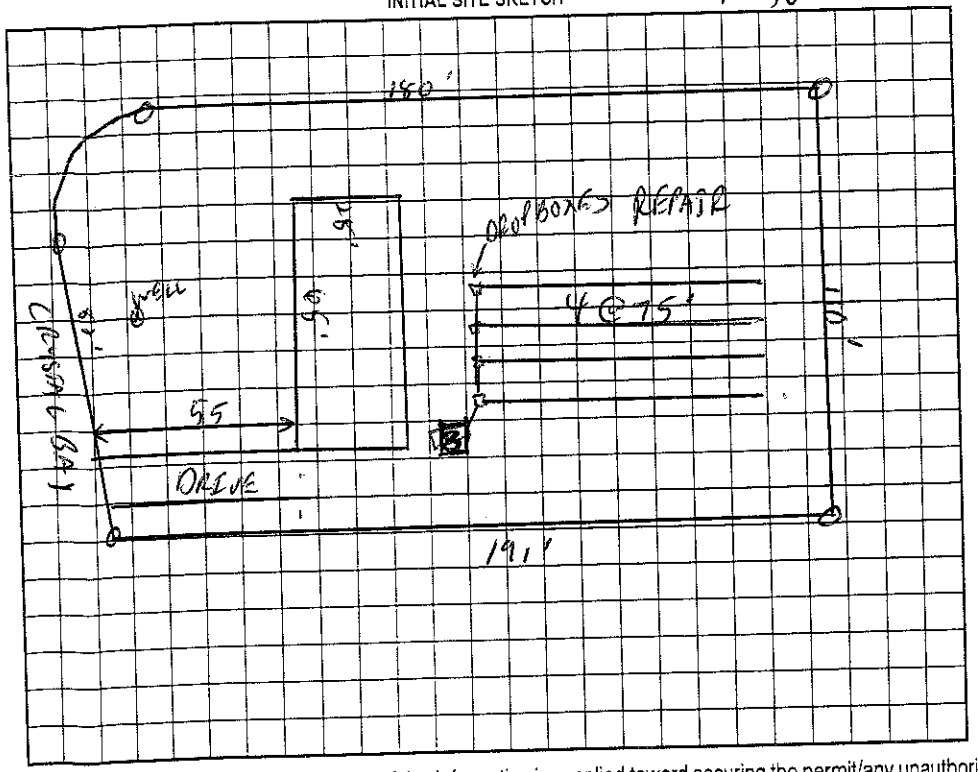

AS BUILT SKETCH

Permit can be suspended or revoked if any false information is supplied toward securing the permit/any unauthorized changes are made to the site/any unauthorized changes are made in the installation of the system. Improvement Permit with plat valid without expiration. Improvement Permit with site plan valid for sixty months. Authorization to Construct is valid for a period equal to that of Improvement Permit – not to exceed sixty months.

Signed: _____ date 3/6/01

Improvement Permit by: _____ HS date 3/6/01

Authorization to Construct by: _____ HS date 3/6/01

Installed by: A-1 Backhoe

Operation Permit by: Wesley Sparks RS. date 5/7/02

Existing System Inspection by: _____ date _____

HEALTH DEPT. COPY: WHITE OWNER COPY (FINAL): YELLOW OWNER COPY (INITIAL): PINK